




THE HONORS COURSE																							
<i>Holes:</i>	<i>1</i>	<i>2</i>	<i>3</i>	<i>4</i>	<i>5</i>	<i>6</i>	<i>7</i>	<i>8</i>	<i>9</i>	<i>Out:</i>		<i>10</i>	<i>11</i>	<i>12</i>	<i>13</i>	<i>14</i>	<i>15</i>	<i>16</i>	<i>17</i>	<i>18</i>	<i>In:</i>		<i>Total:</i>
<i>Tees:</i>																							
<i>Silver</i>	427	580	221	465	511	601	463	226	370	3864		488	593	377	409	175	500	205	546	478	3771	<i>Silver</i>	7635
<i>Black</i>	405	551	200	438	456	548	435	207	360	3600		460	568	355	398	161	449	180	497	440	3508	<i>Black</i>	7108
<i>Blue</i>	385	513	185	428	425	523	413	183	353	3408		422	553	342	387	150	424	164	474	425	3341	<i>Blue</i>	6749
<i>Orange</i>	356	487	176	407	369	517	401	157	341	3211		407	539	329	381	136	379	155	468	403	3197	<i>Orange</i>	6408
<i>Green</i>	354	475	156	364	362	494	378	146	332	3061		361	500	323	336	122	370	148	443	384	2987	<i>Green</i>	6048
<i>White</i>	317	417	153	345	354	478	288	133	276	2761		354	490	315	321	97	302	133	437	349	2798	<i>White</i>	5559
<i>Red</i>	281	410	135	315	282	424	261	111	272	2491		335	447	259	284	90	296	113	379	309	2512	<i>Red</i>	5003
The Honors Course																							
Ooltewah, TN Date: 013023																							



ATIS GOLF LAND WATER
487 Daddy Green Rd
Christiana, TN 37037
www.GolfLandWater.com
(561) 371-1815

The drawings and written material herein constitute original work of the architect and its creation, and as such are the property of the architect. No part of this document may be reproduced, stored in a retrieval system, or transmitted in any form or by any means, electronic, mechanical, published, or recorded in any way without the express written consent of the architect and its creation.

THE HONORS COURSE OOLTEWAH, TENNESSEE

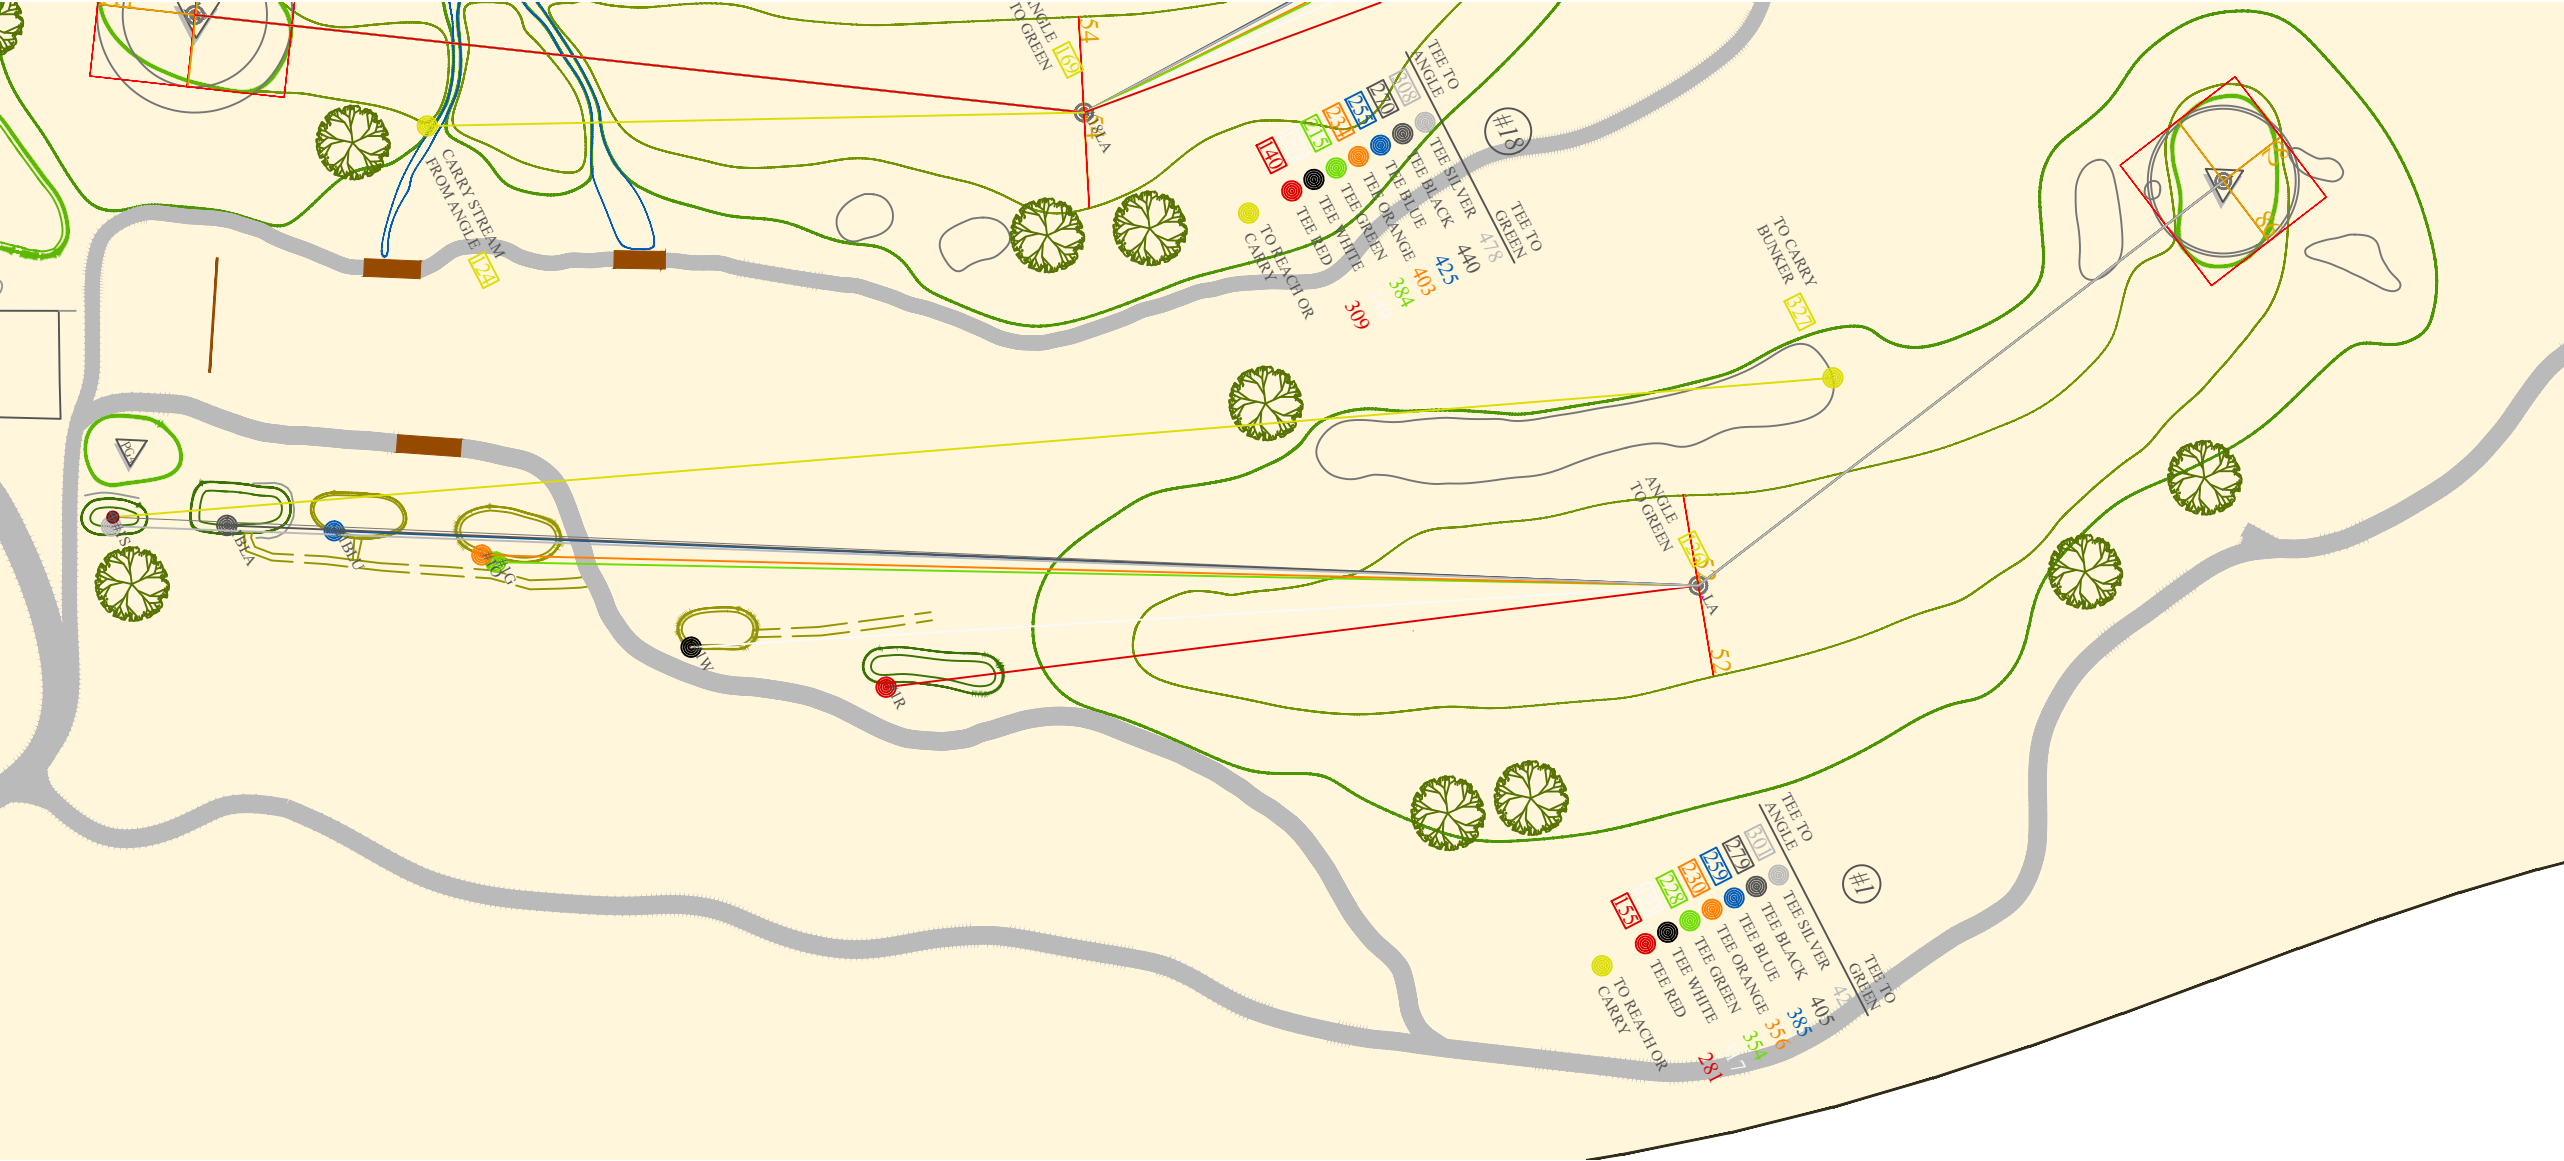

FV #1

January 30, 2023
ATIS Honors Golf by Asbuilt Yardage Jan 30 2023.dwg
TAH


GOLF YARDAGE ASBUILT

ATIS GOLF LAND WATER
487 Daddy Green Rd
Christiana, TN 37037
www.GolfLandWater.com
(561) 371-1815



The drawings and related material herein constitute original work of the architect and is intended as a professional product and instrument of service, not subject to copyright and may not be reproduced, stored in a retrieval system, or used in any form without the express consent of the architect and its affiliates.

THE HONORS COURSE OOLTEWAH, TENNESSEE

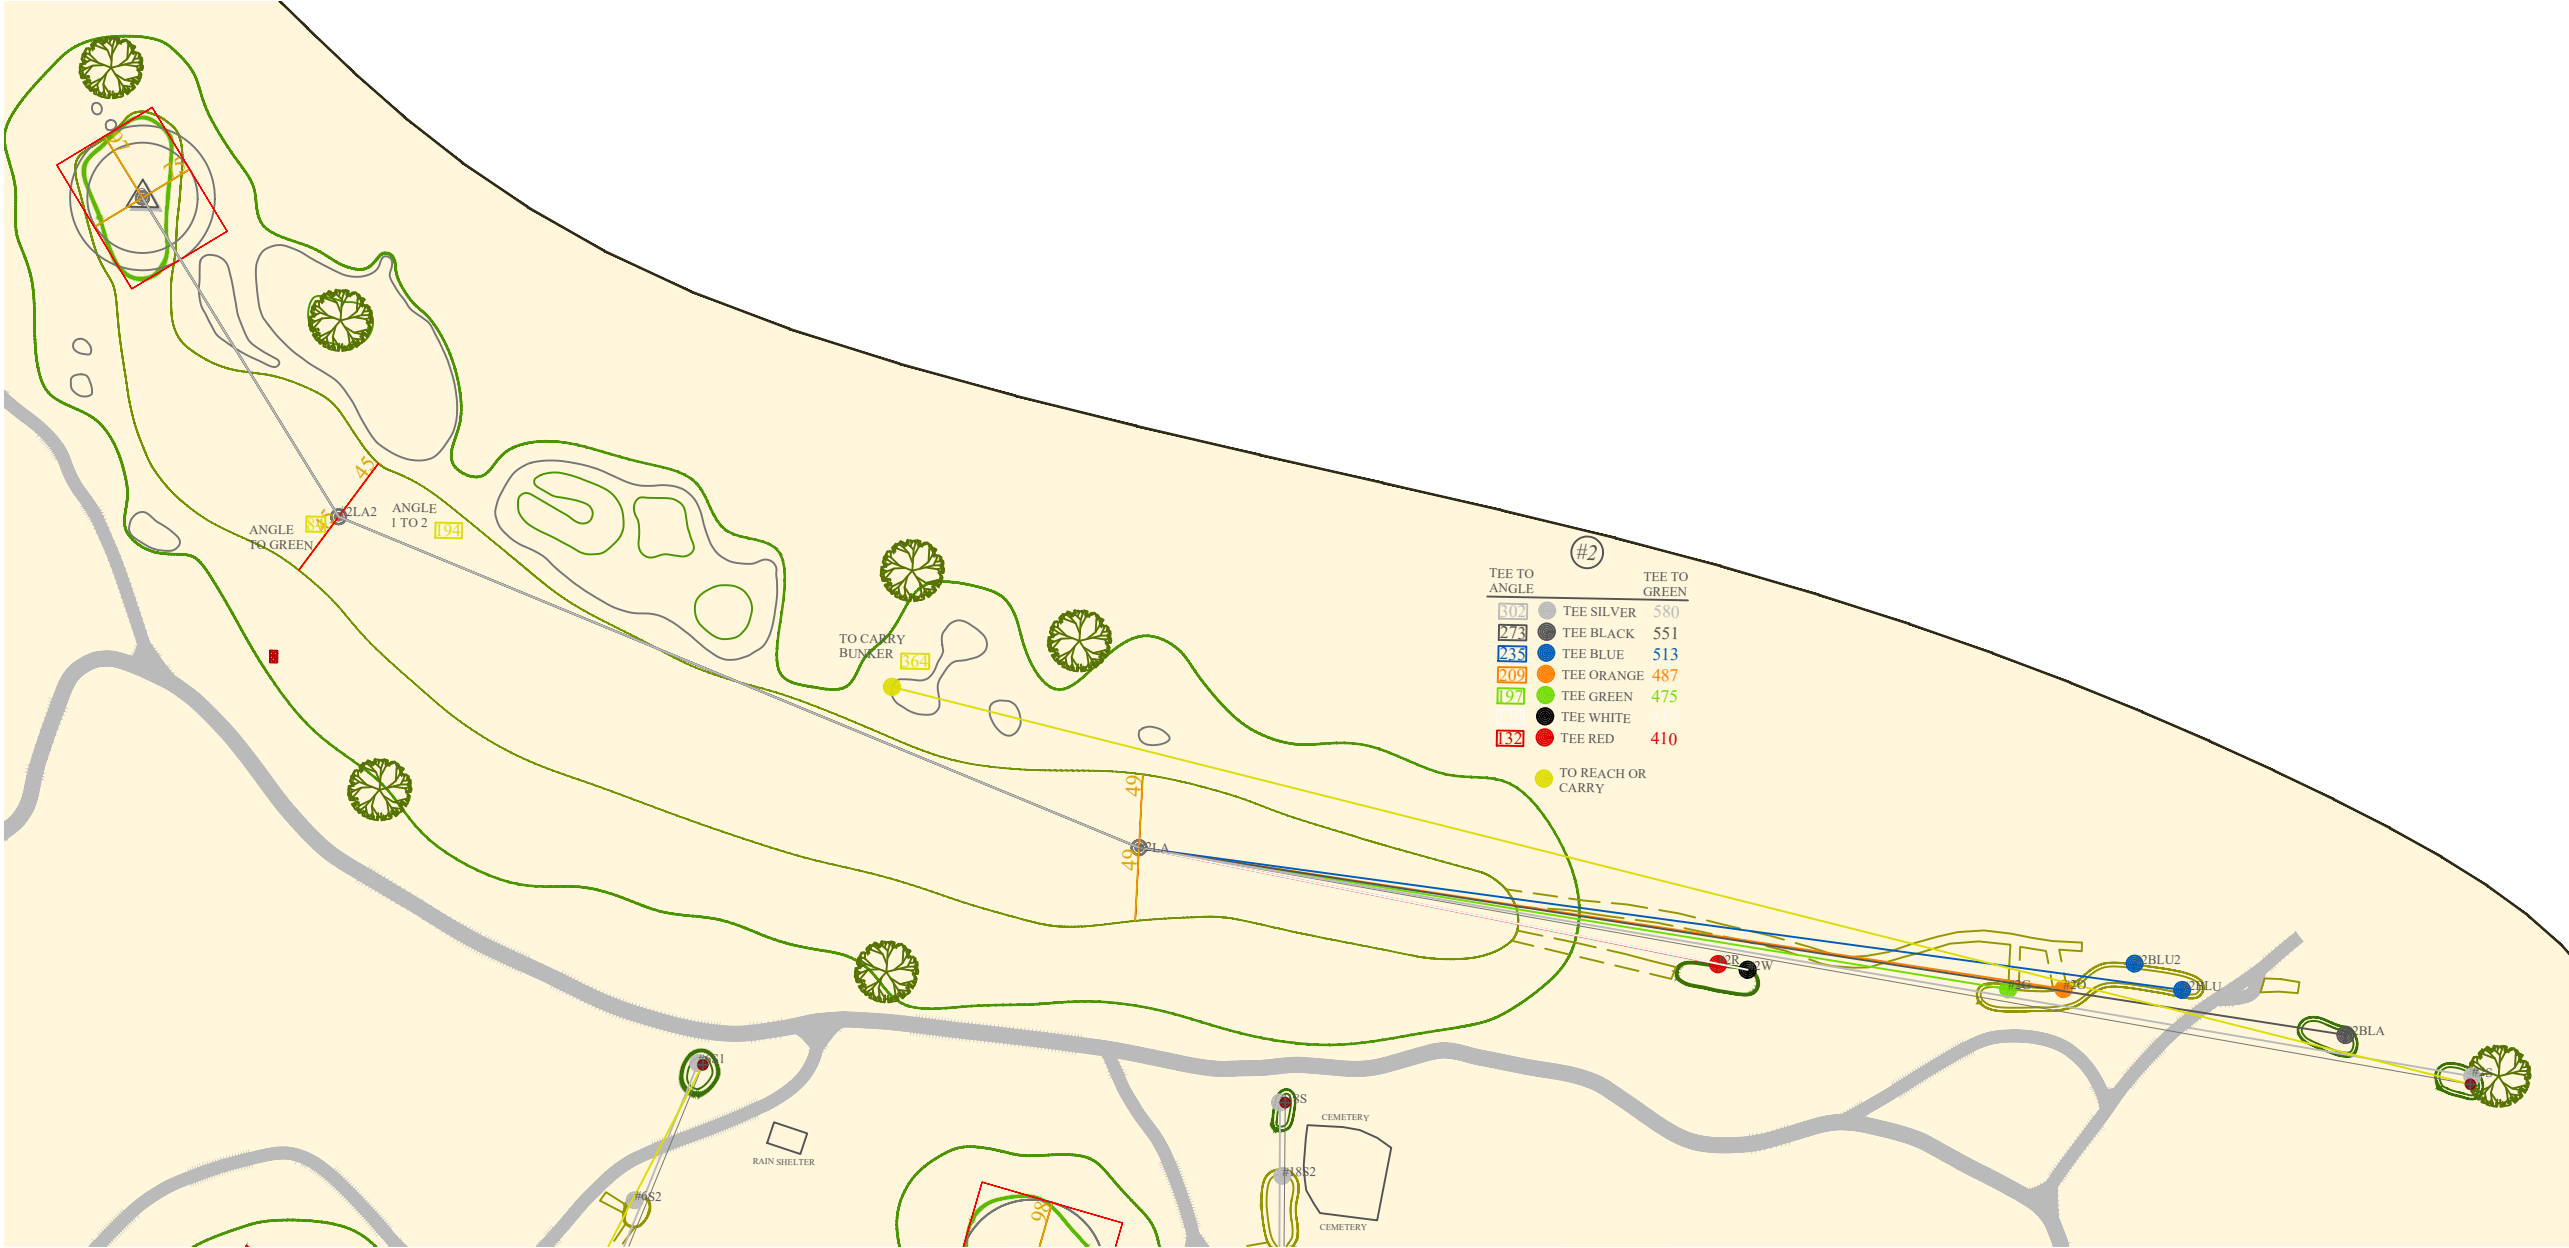

FV #2


January 30, 2023
ATIS Honors Golf for Ashbult Yardages Jan 30 2023.dwg
TAH

SCALE
N.T.S.

GOLF YARDAGE ASBUILT


ATIS GOLF LAND WATER
487 Daddy Green Rd
Christiana, TN 37037
www.GolfLandWater.com
(561) 371-1815



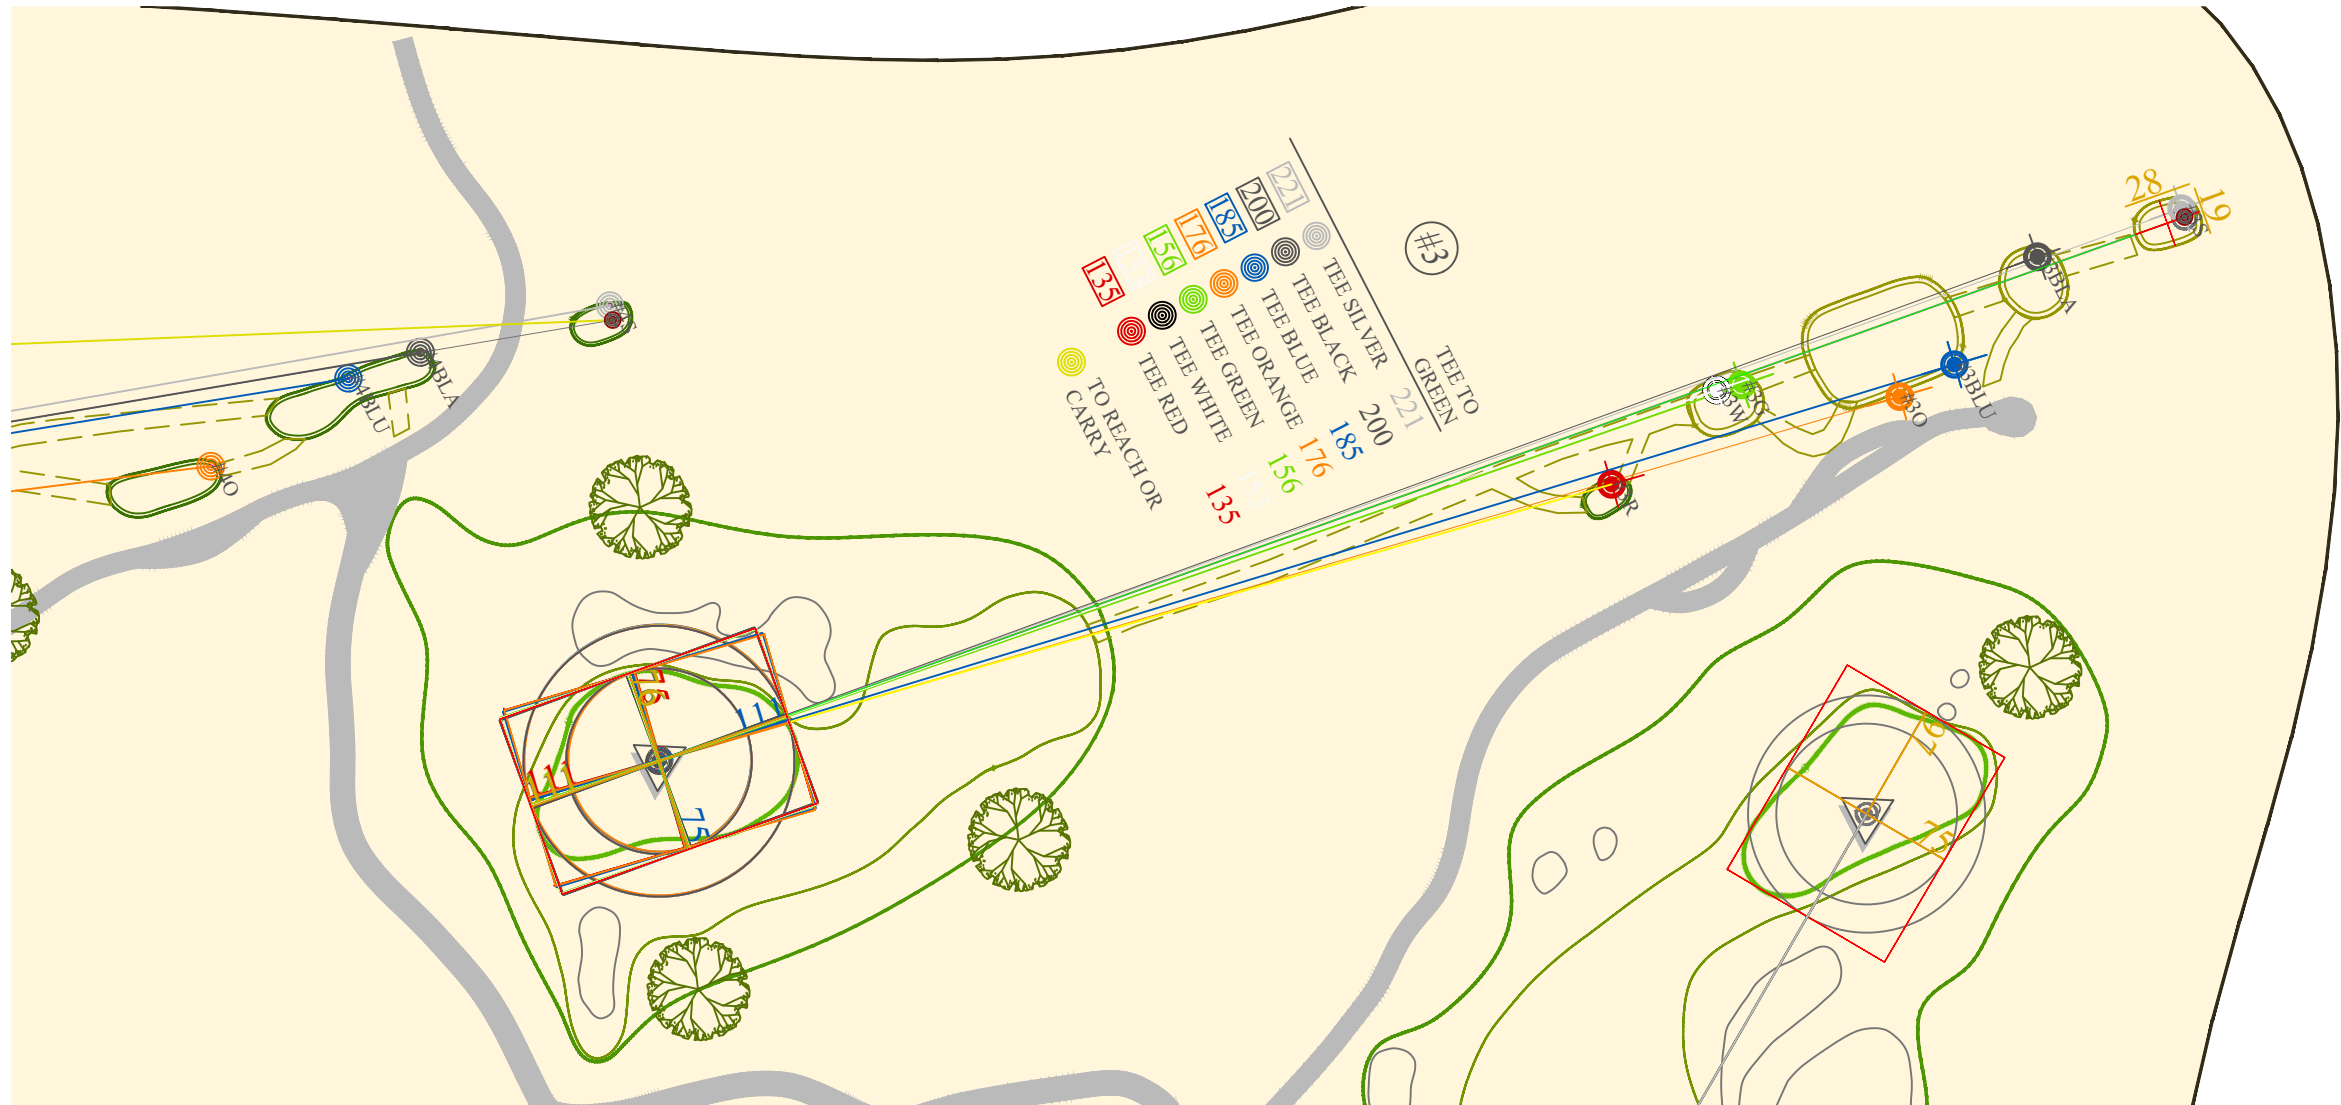

The drawings and written material herein constitute original work of the author and as such, are the property of the author. No part of this publication may be reproduced, stored in a retrieval system, or transmitted in any form or by any means, electronic, mechanical, photocopying, recording, or by any information storage and retrieval system, without the prior written permission of the author and/or publisher.

THE HONORS COURSE COLTEWAH, TENNESSEE

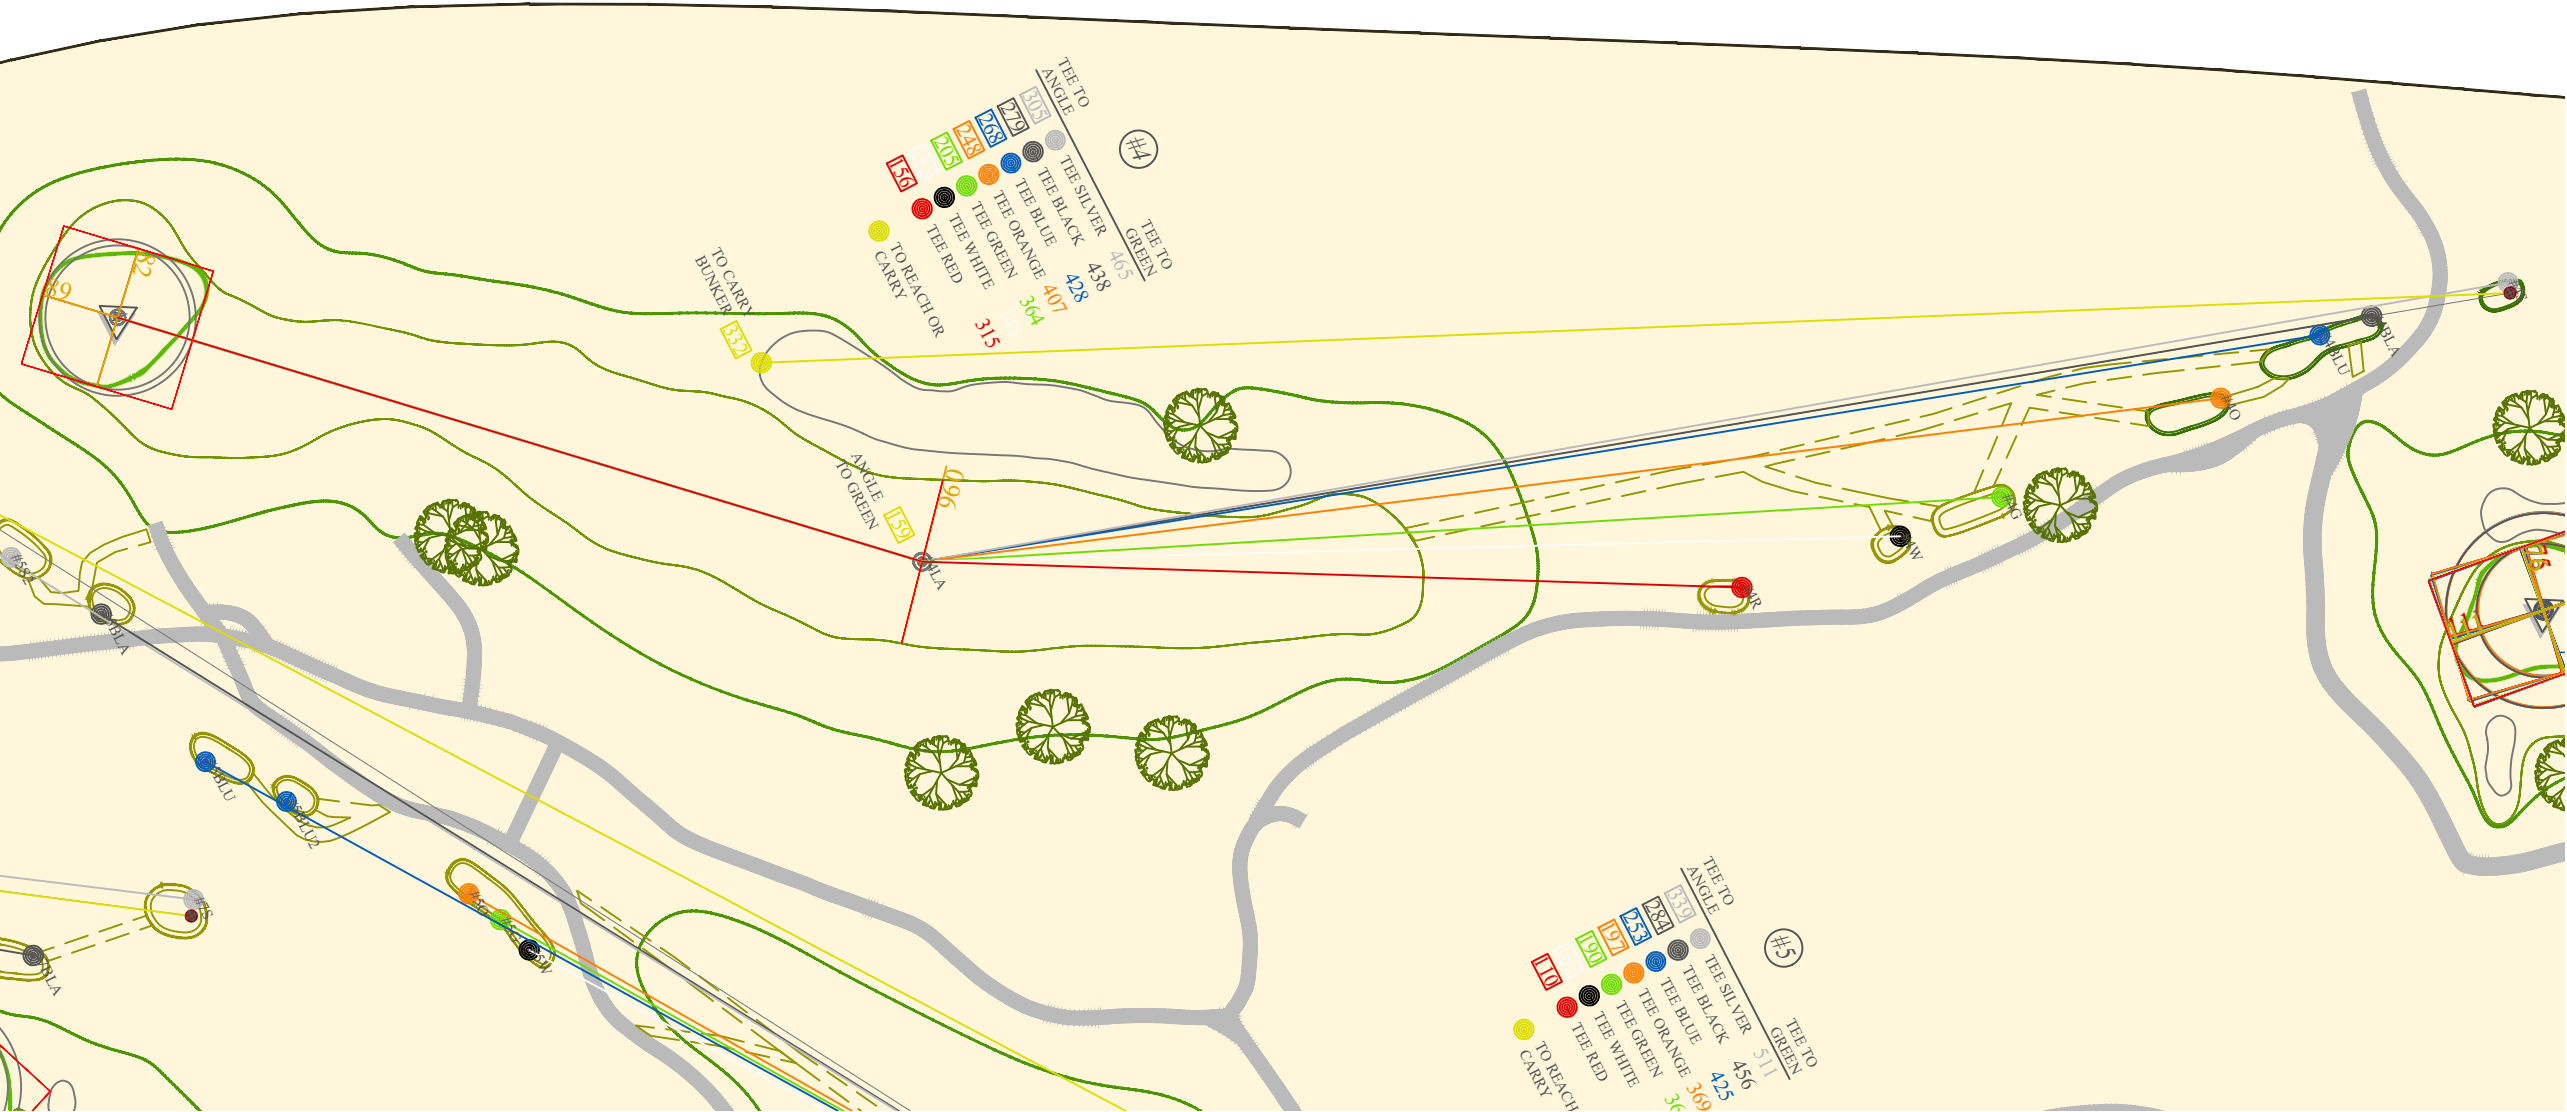

The drawings and written material herein constitute the entire work of the architect and its contents, including all drawings and specifications, are subject to copyright and may not be reproduced, stored in a retrieval system, or used in any form without the express written consent of the architect and its associates.

THE HONORS COURSE COLTEWAH, TENNESSEE



FV #5

January 30, 2023
TAH


GOLF YARDAGE ASBUILT

ATIS GOLF LAND WATER
487 Daddy Green Rd
Christiana, TN 37037
www.GolfLandWater.com
(561) 371-1815



The drawings and written material herein constitute original work of the author and is considered an intellectual property and no part of it may be reproduced, stored in a retrieval system, or transmitted in any form or by any means, electronic, mechanical, photocopying, recording, or by any information storage and retrieval system, without the prior written permission of the author and/or publisher.

THE HONORS COURSE OOLTEWAH, TENNESSEE

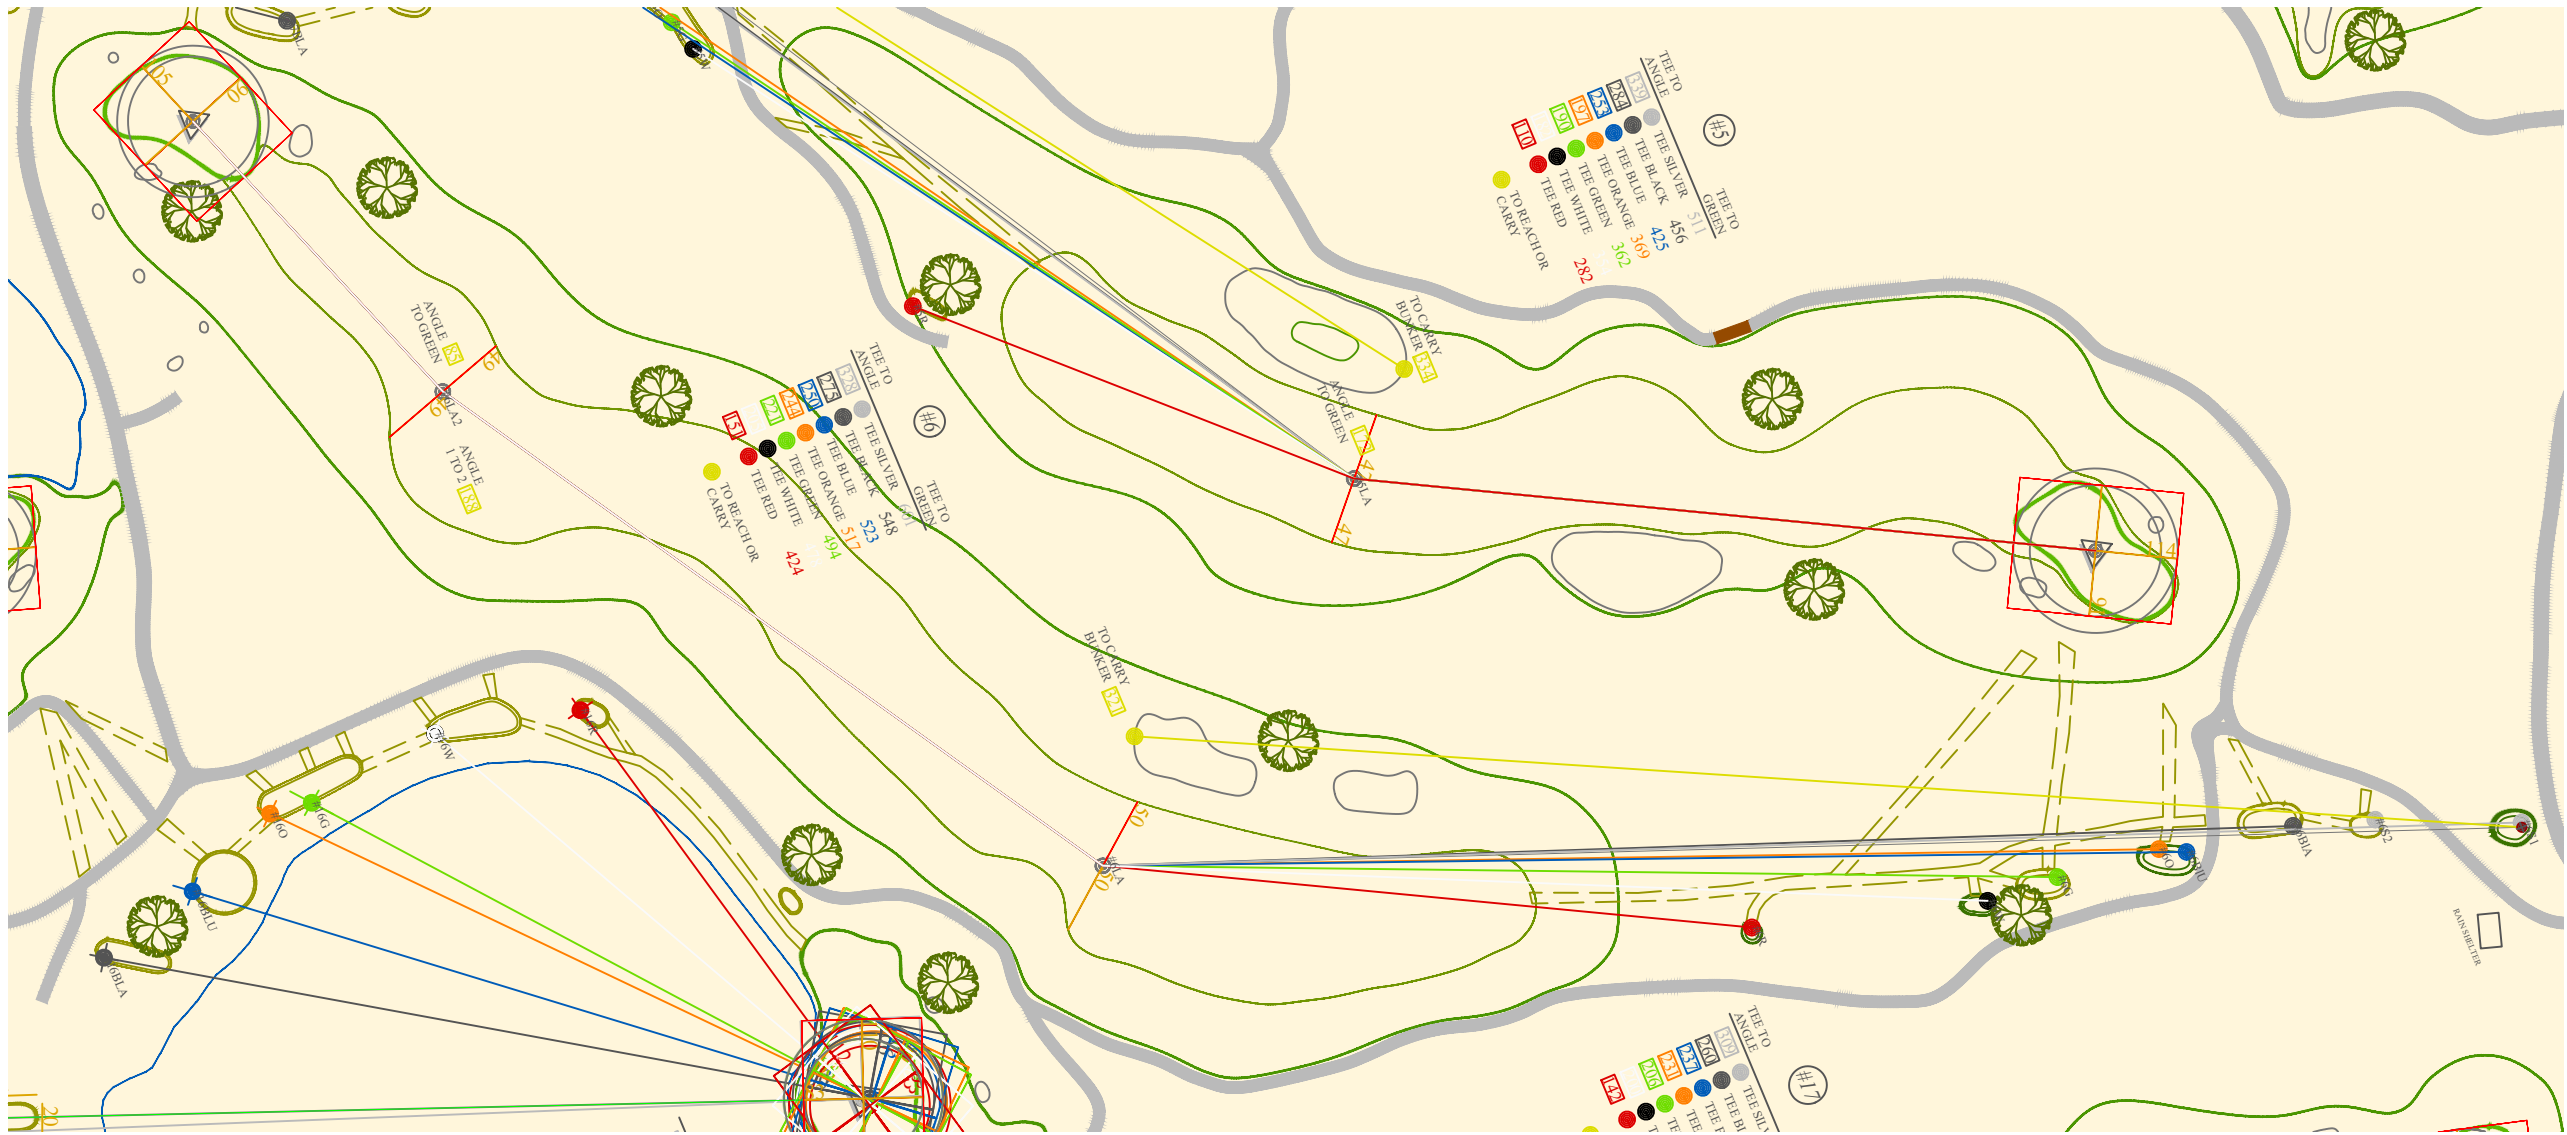

FV #6

January 30, 2023
ATIS Honors Golf by Ashbult Yardage Jan 30 2023.dwg
TAH


GOLF YARDAGE ASBUILT

ATIS GOLF LAND WATER
487 Daddy Green Rd
Christiana, TN 37037
www.GolfLandWater.com
(561) 371-1815



The drawings and written material herein constitute a contract and are to be read and interpreted as such. No other drawings or specifications shall be used in the construction of the project without the express written consent of the architect and in accordance with the contract documents.

THE HONORS COURSE OOLTEWAH, TENNESSEE

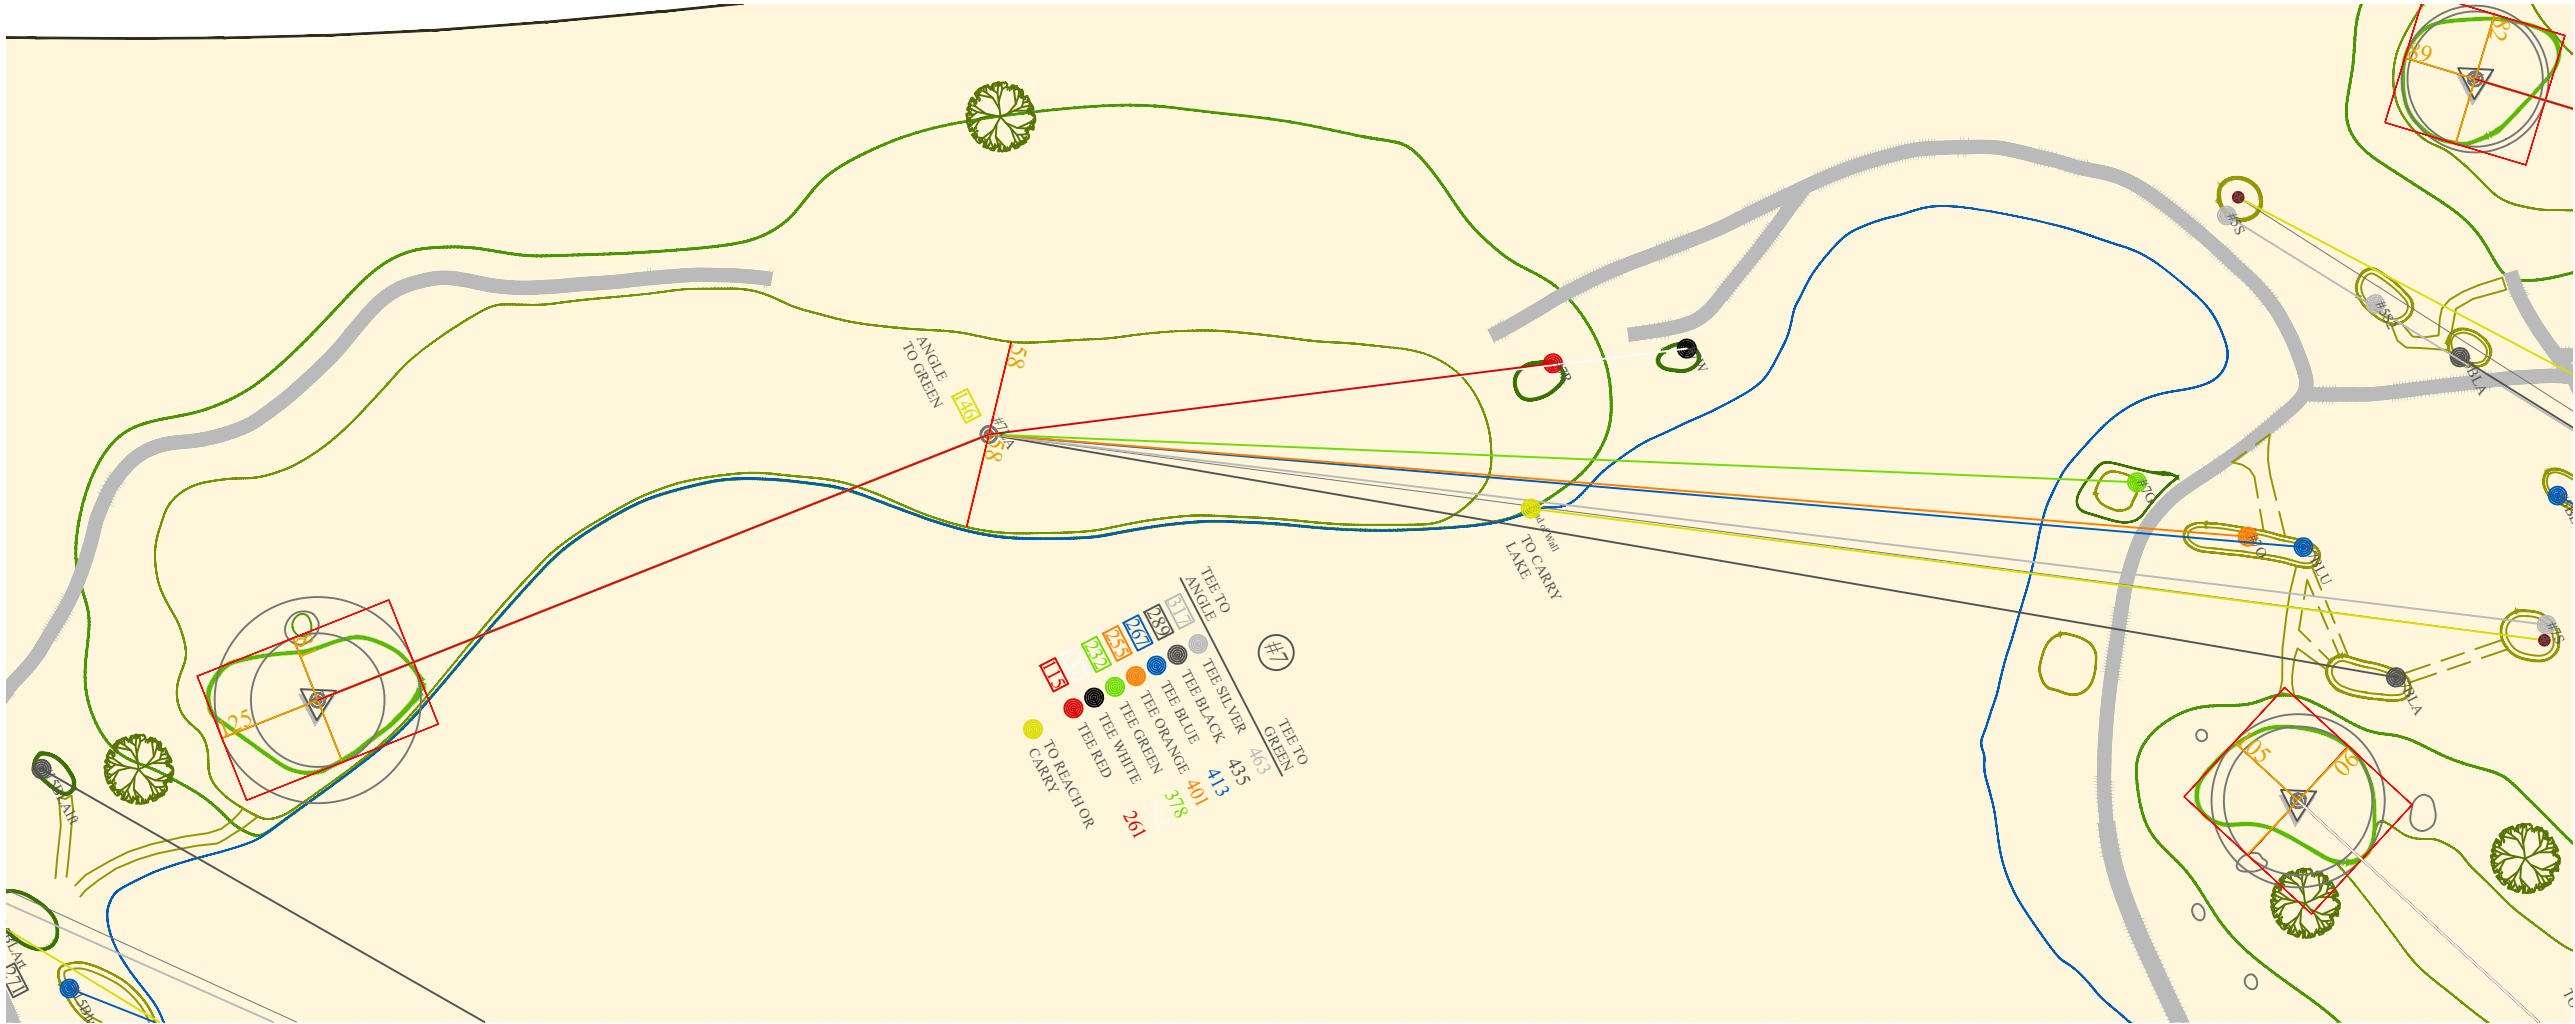

FV #7

January 30, 2023
ATIS Honors Golf for Asbuilt Yardage Jan 30 2023.dwg
TAH


GOLF YARDAGE ASBUILT

ATIS GOLF LAND WATER
487 Daddy Green Rd
Christiana, TN 37037
www.GolfLandWater.com
(561) 371-1815




The drawings and written material herein constitute original work of the author and its creation and its publication are subject to copyright. All rights are reserved. No part of this publication may be reproduced, stored in a retrieval system, or transmitted, in any form or by any means, electronic, mechanical, photocopying, recording, or by any information storage or retrieval system, without the prior written permission of the author and/or publisher.

THE HONORS COURSE OOLTEWAH, TENNESSEE

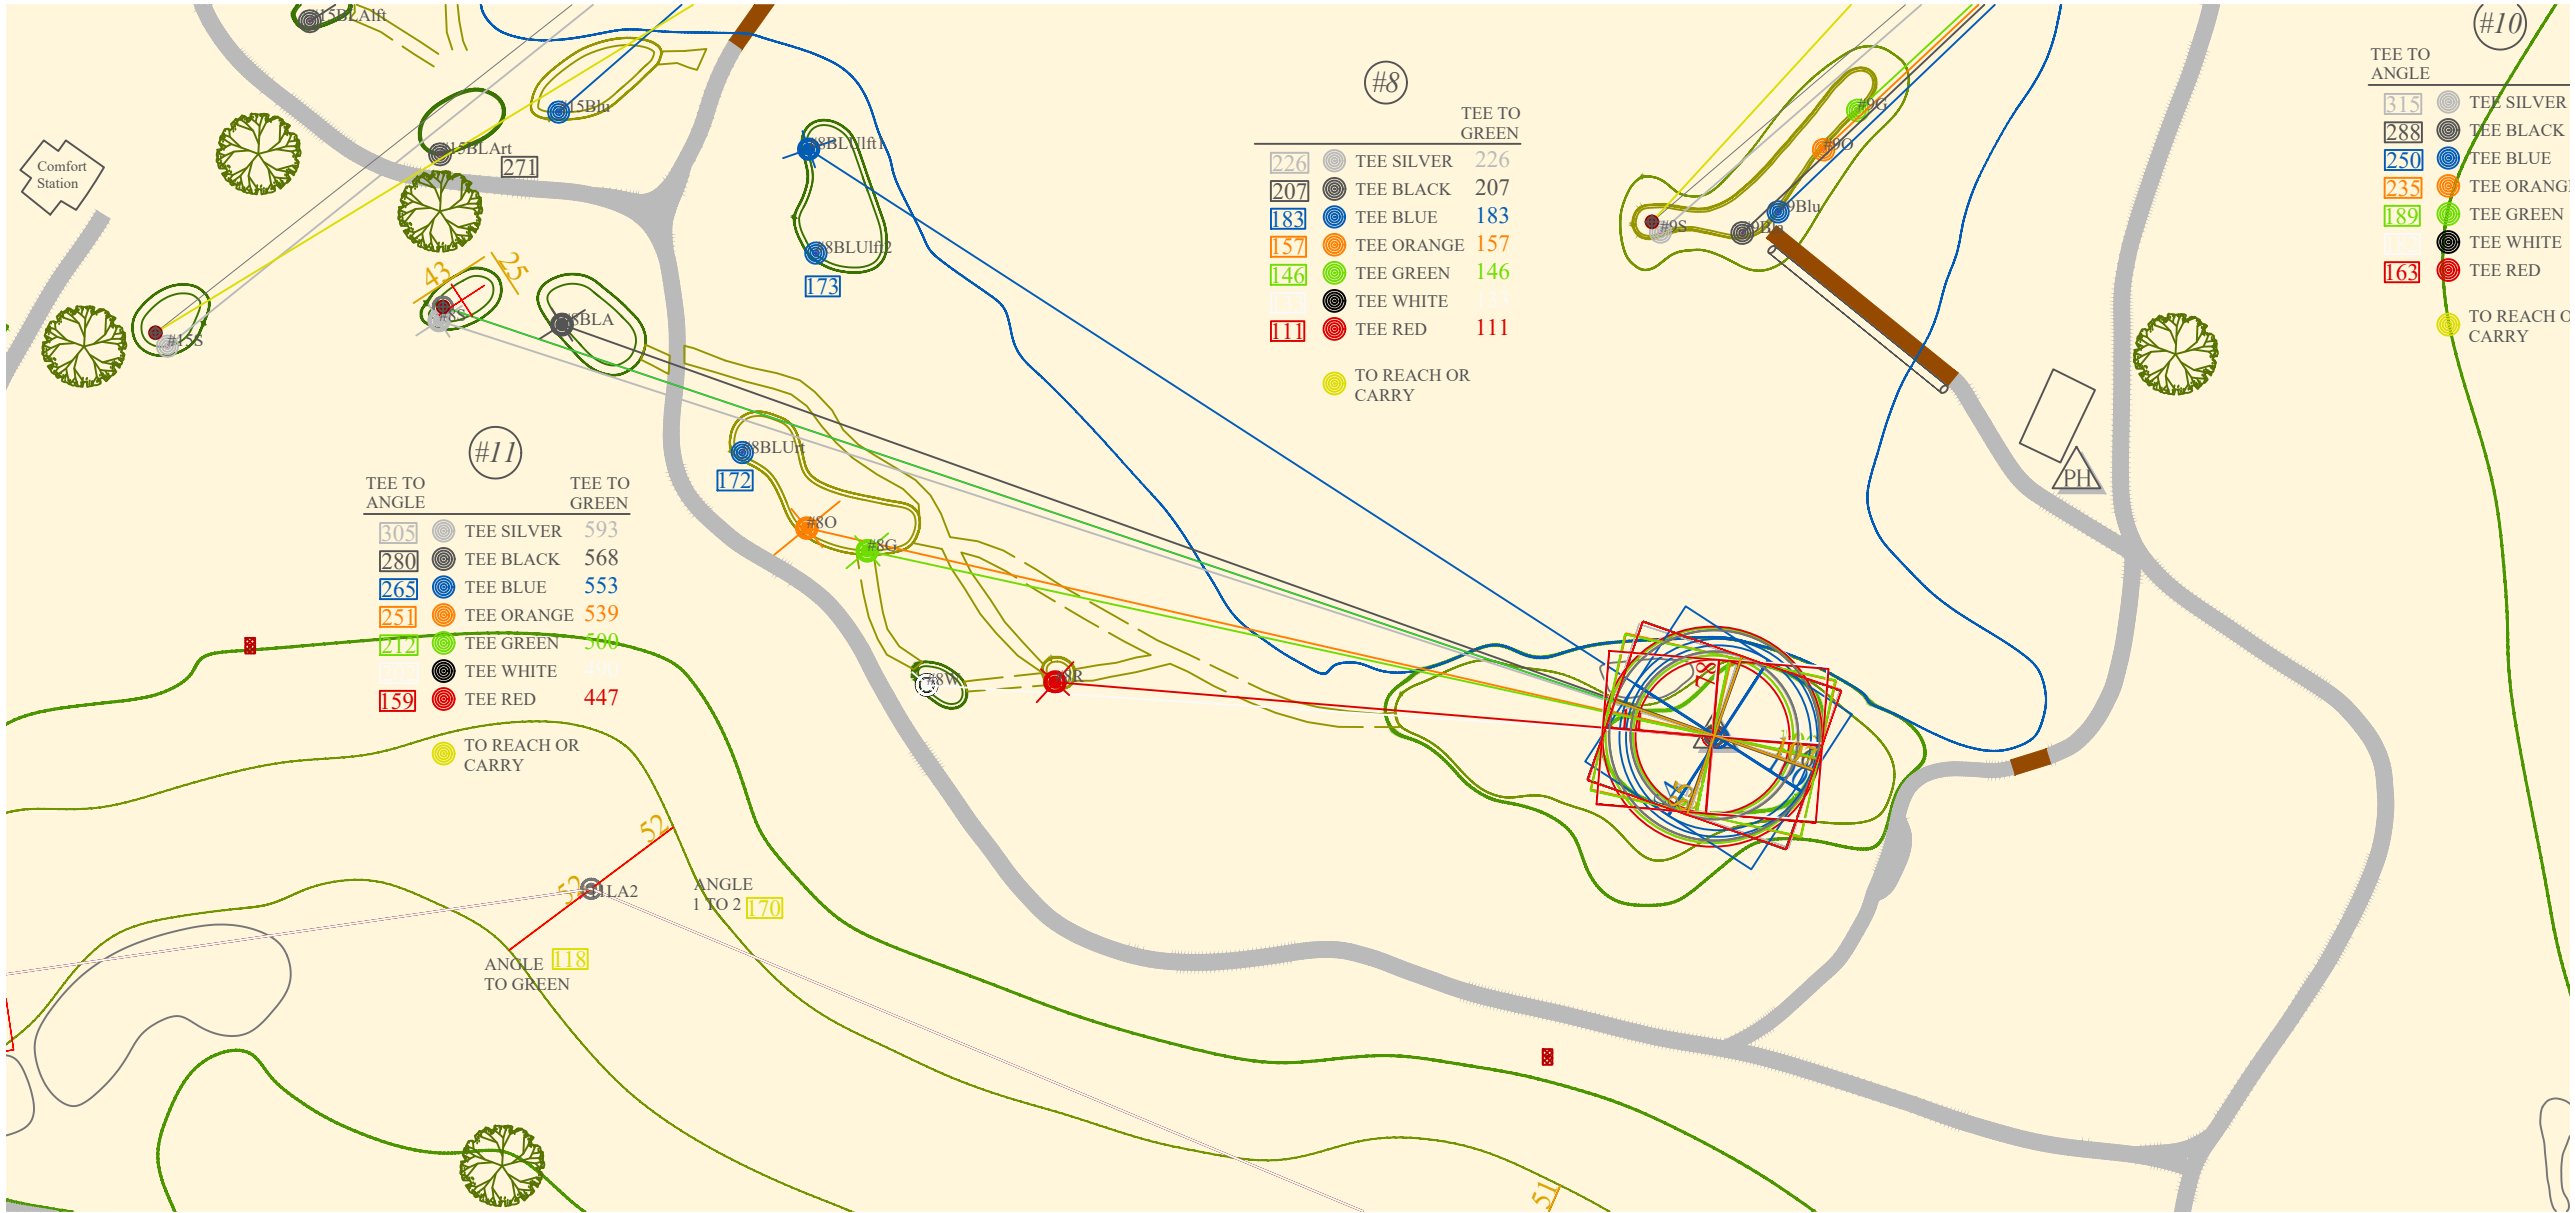


The drawings and written material herein constitute original work of the architect and its consultant, and no other person or organization has any right to copy or reproduce the drawings or written material without the written consent of the architect and its consultant.

THE HONORS COURSE COLTEWAH, TENNESSEE

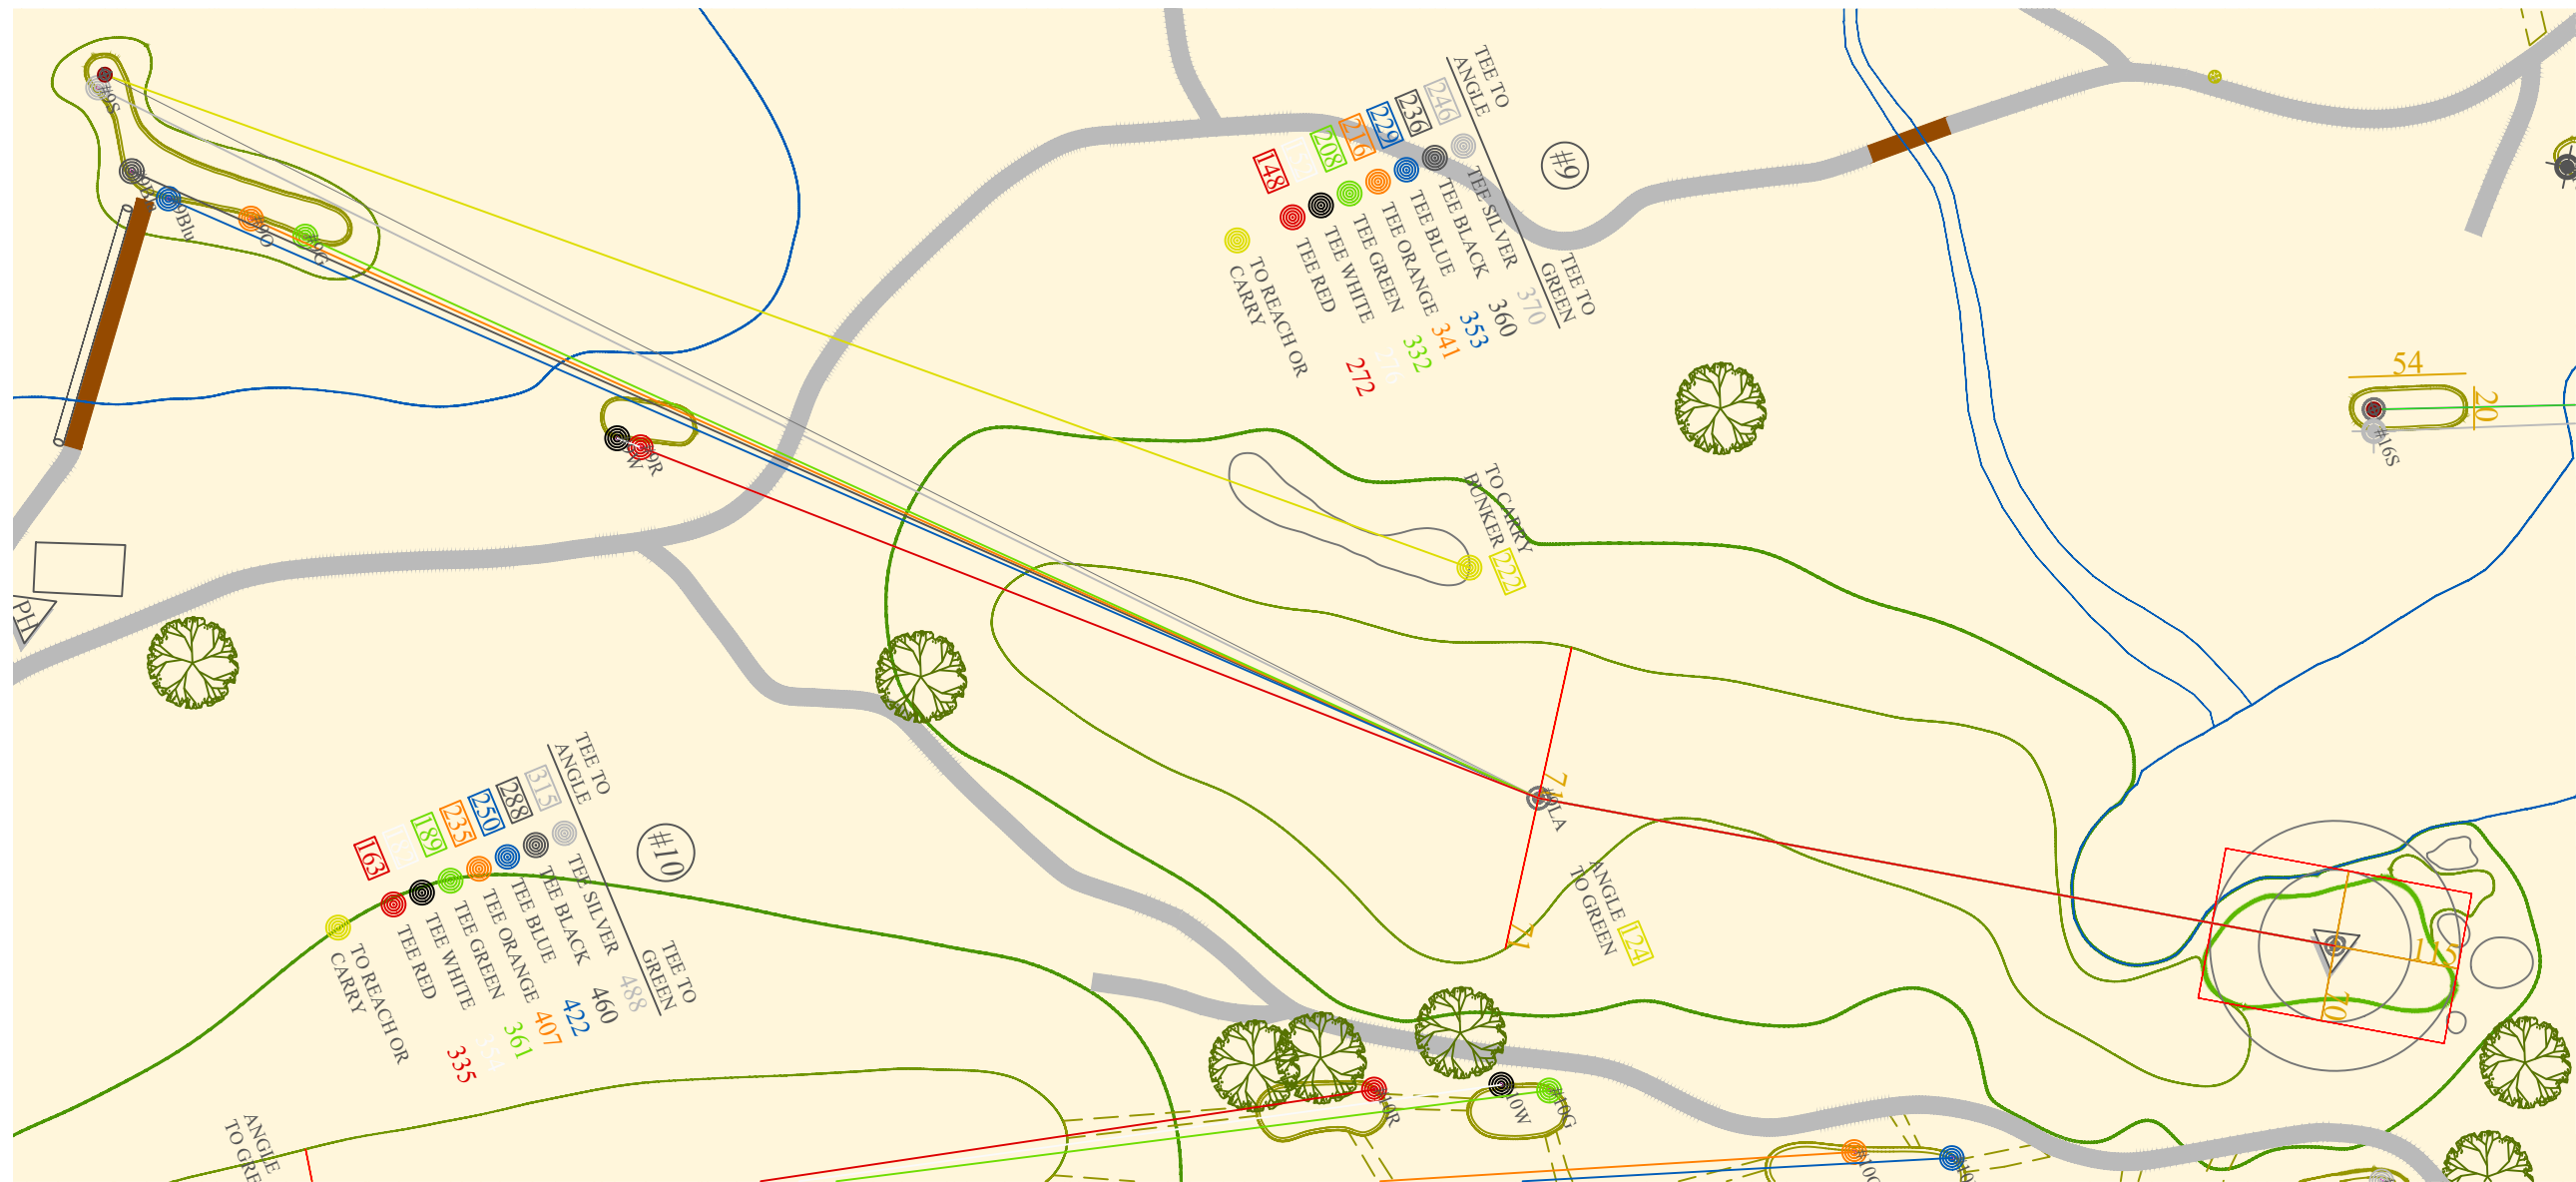


The drawings and written material herein constitute original work of the author and are intended for the use of the author only. No part of this publication may be reproduced, stored in a retrieval system, or transmitted, in any form or by any means, electronic, mechanical, photocopying, recording, or by any information storage or retrieval system, without the prior written consent of the author and is prohibited.

THE HONORS COURSE OOLTEWAH, TENNESSEE

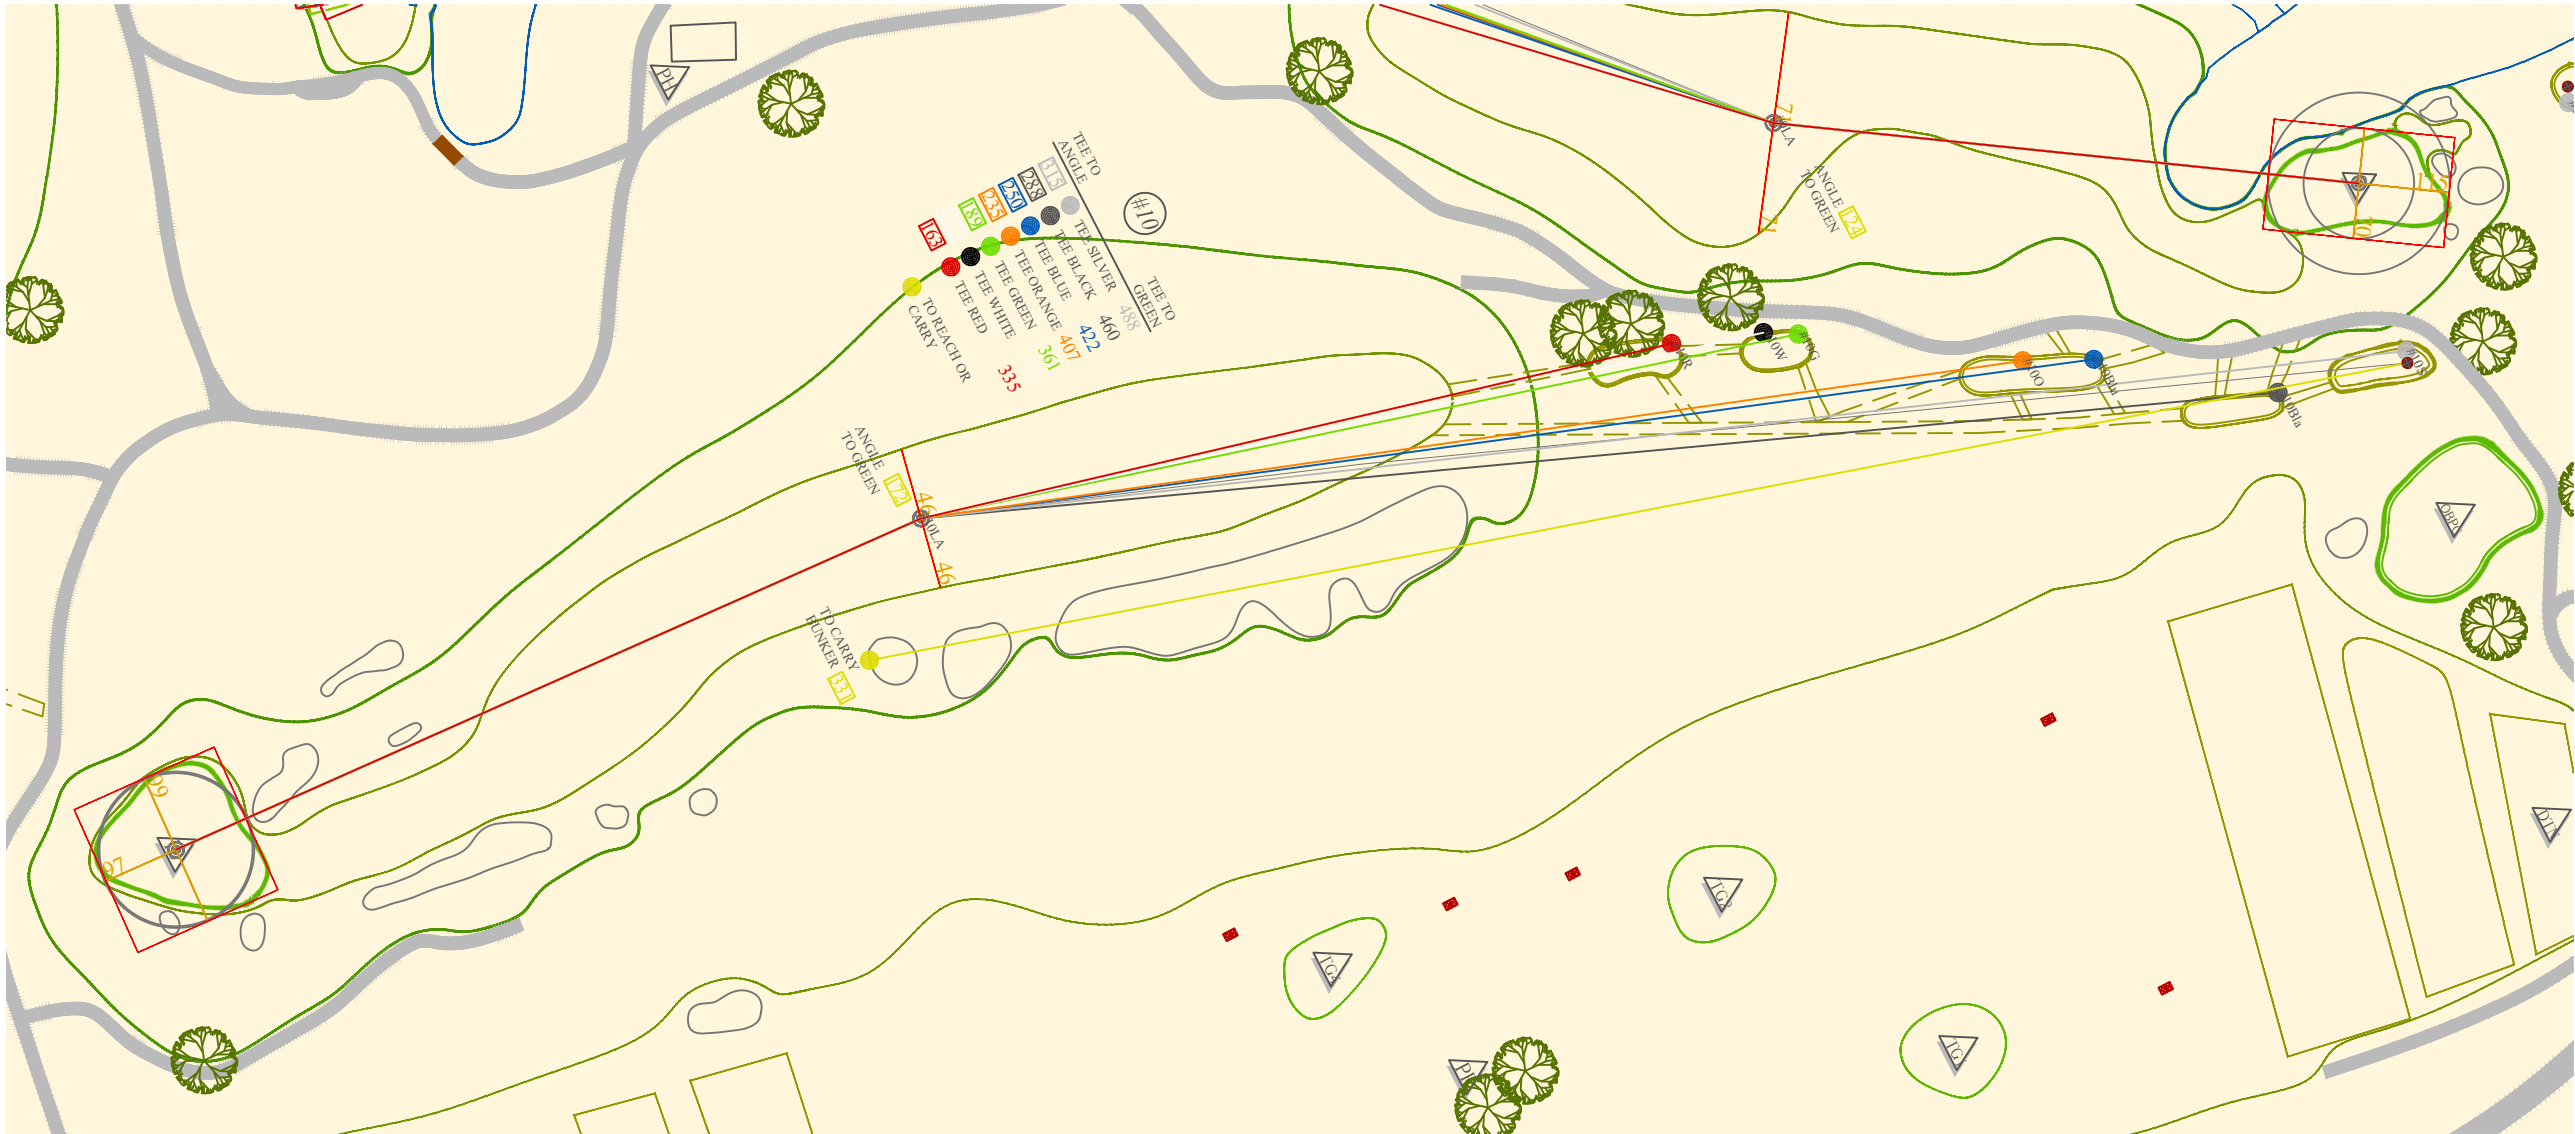


The drawings and written material herein constitute original work of the author and are copyright, and no other person may reproduce or transmit, in whole or in part, or use in any way without the express written consent of the author and is prohibited.

THE HONORS COURSE OOLTEWAH, TENNESSEE

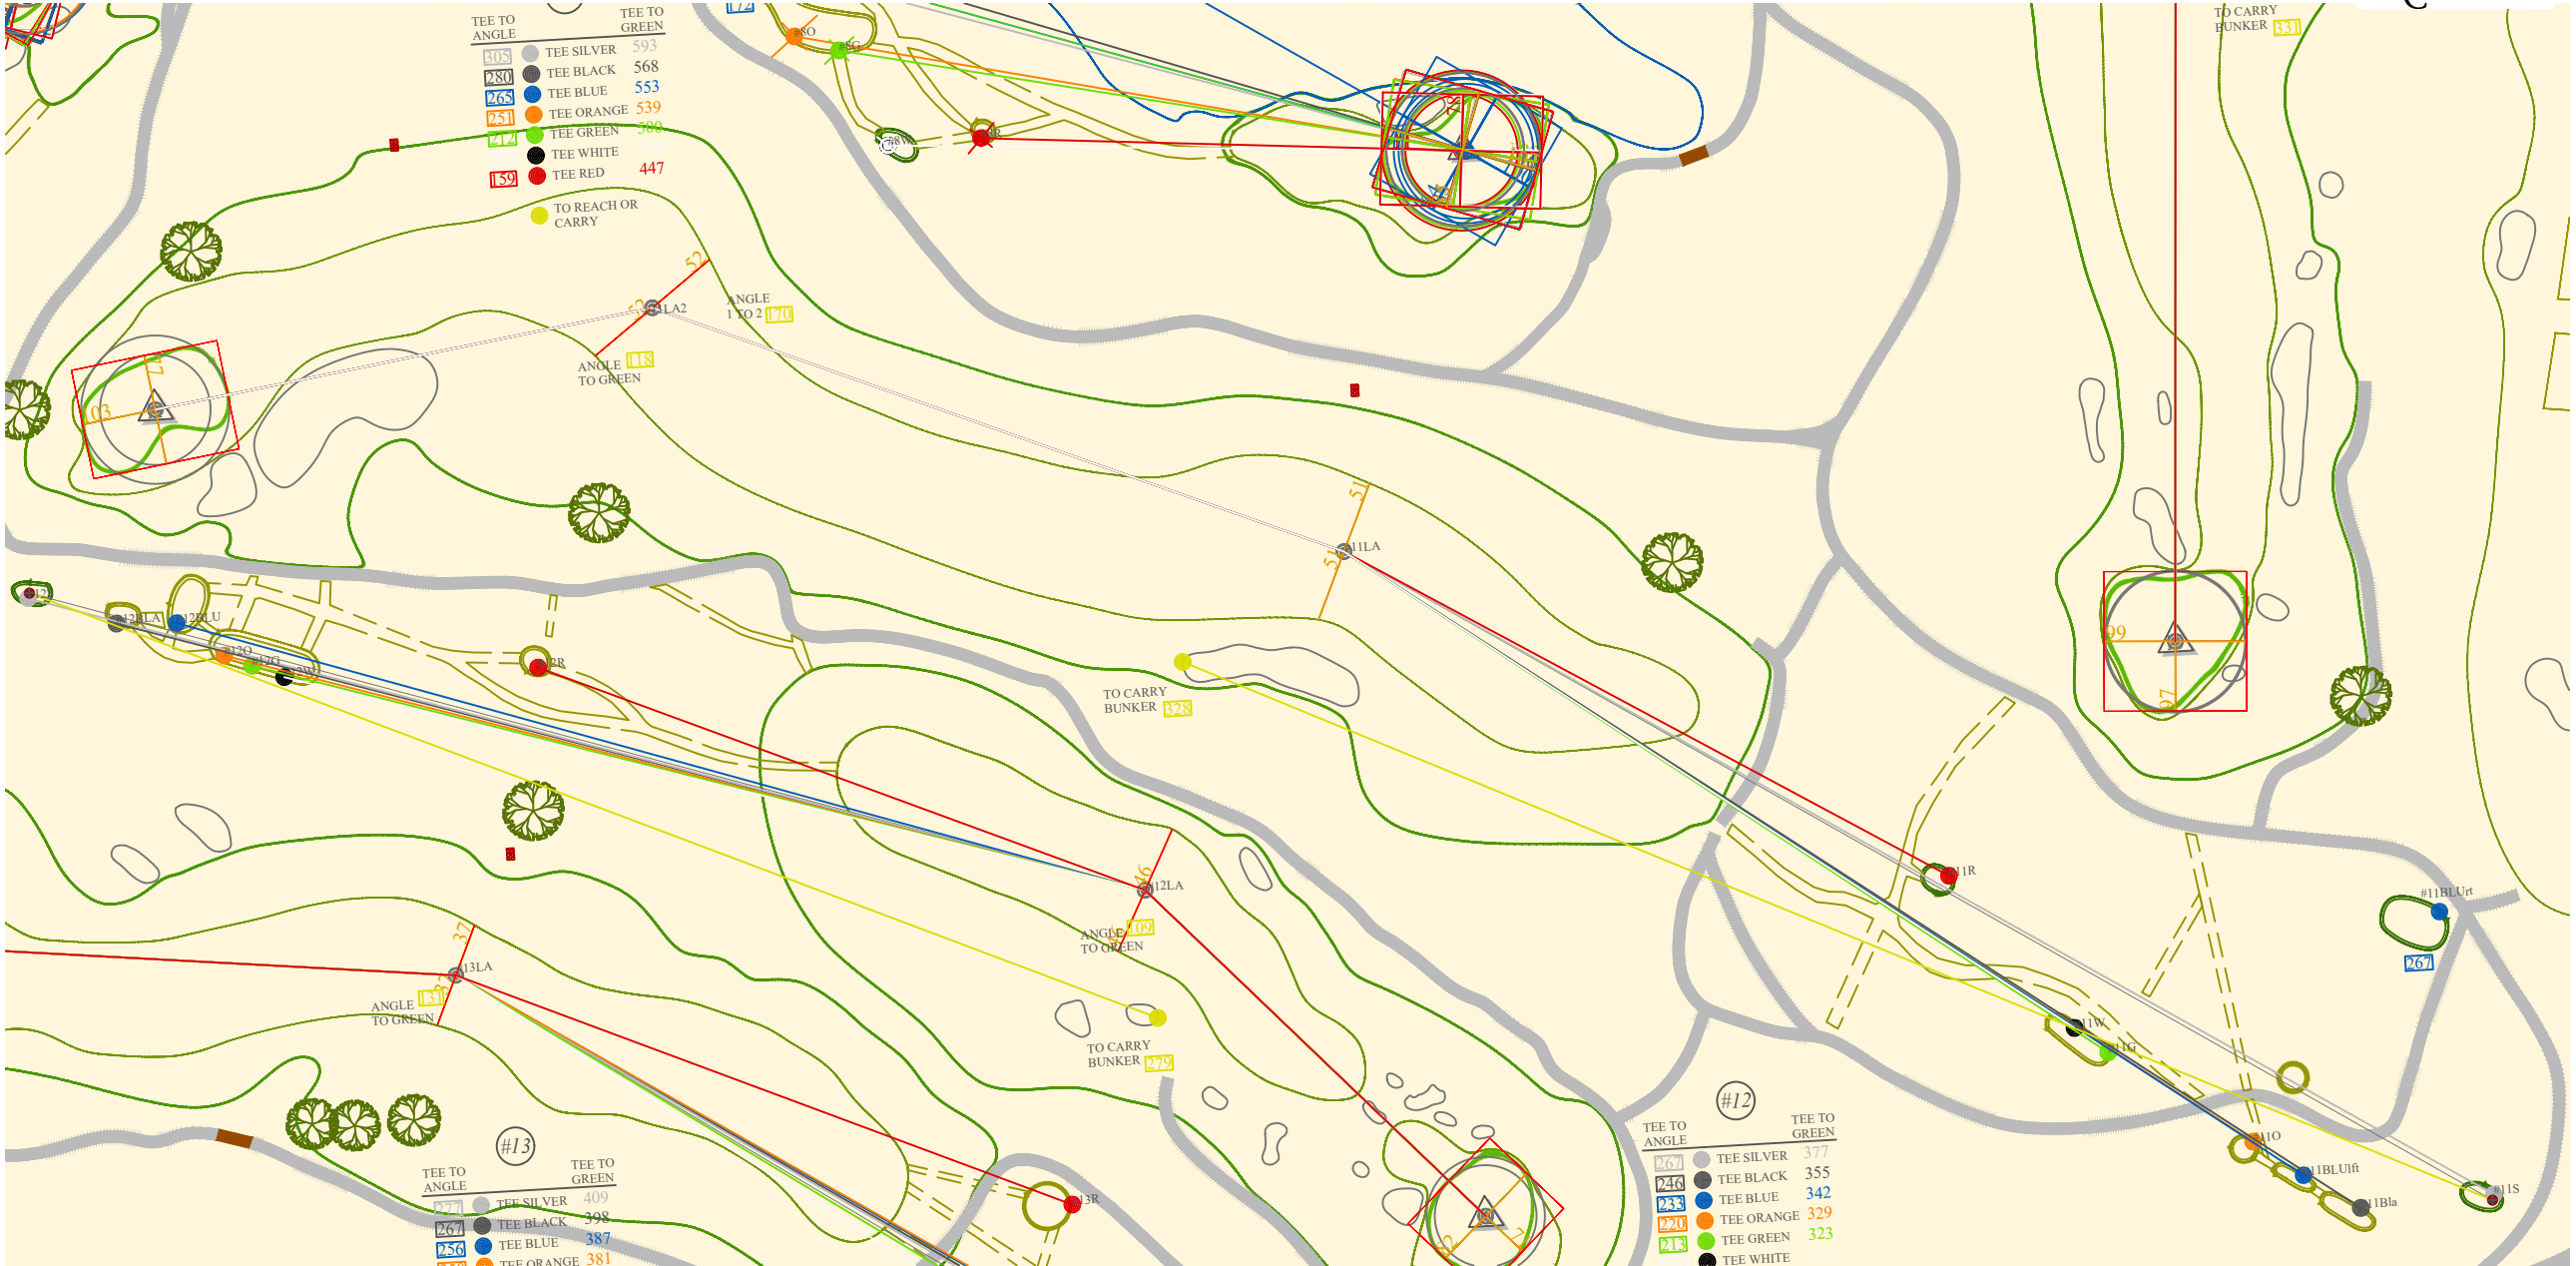


The drawings and written material herein constitute original work of the author and is confidential and no disclosure, copying, or reproduction of any kind is permitted without the prior written consent of the author. The author assumes no responsibility for the accuracy of the information provided.

THE HONORS COURSE OOLTEWAH, TENNESSEE

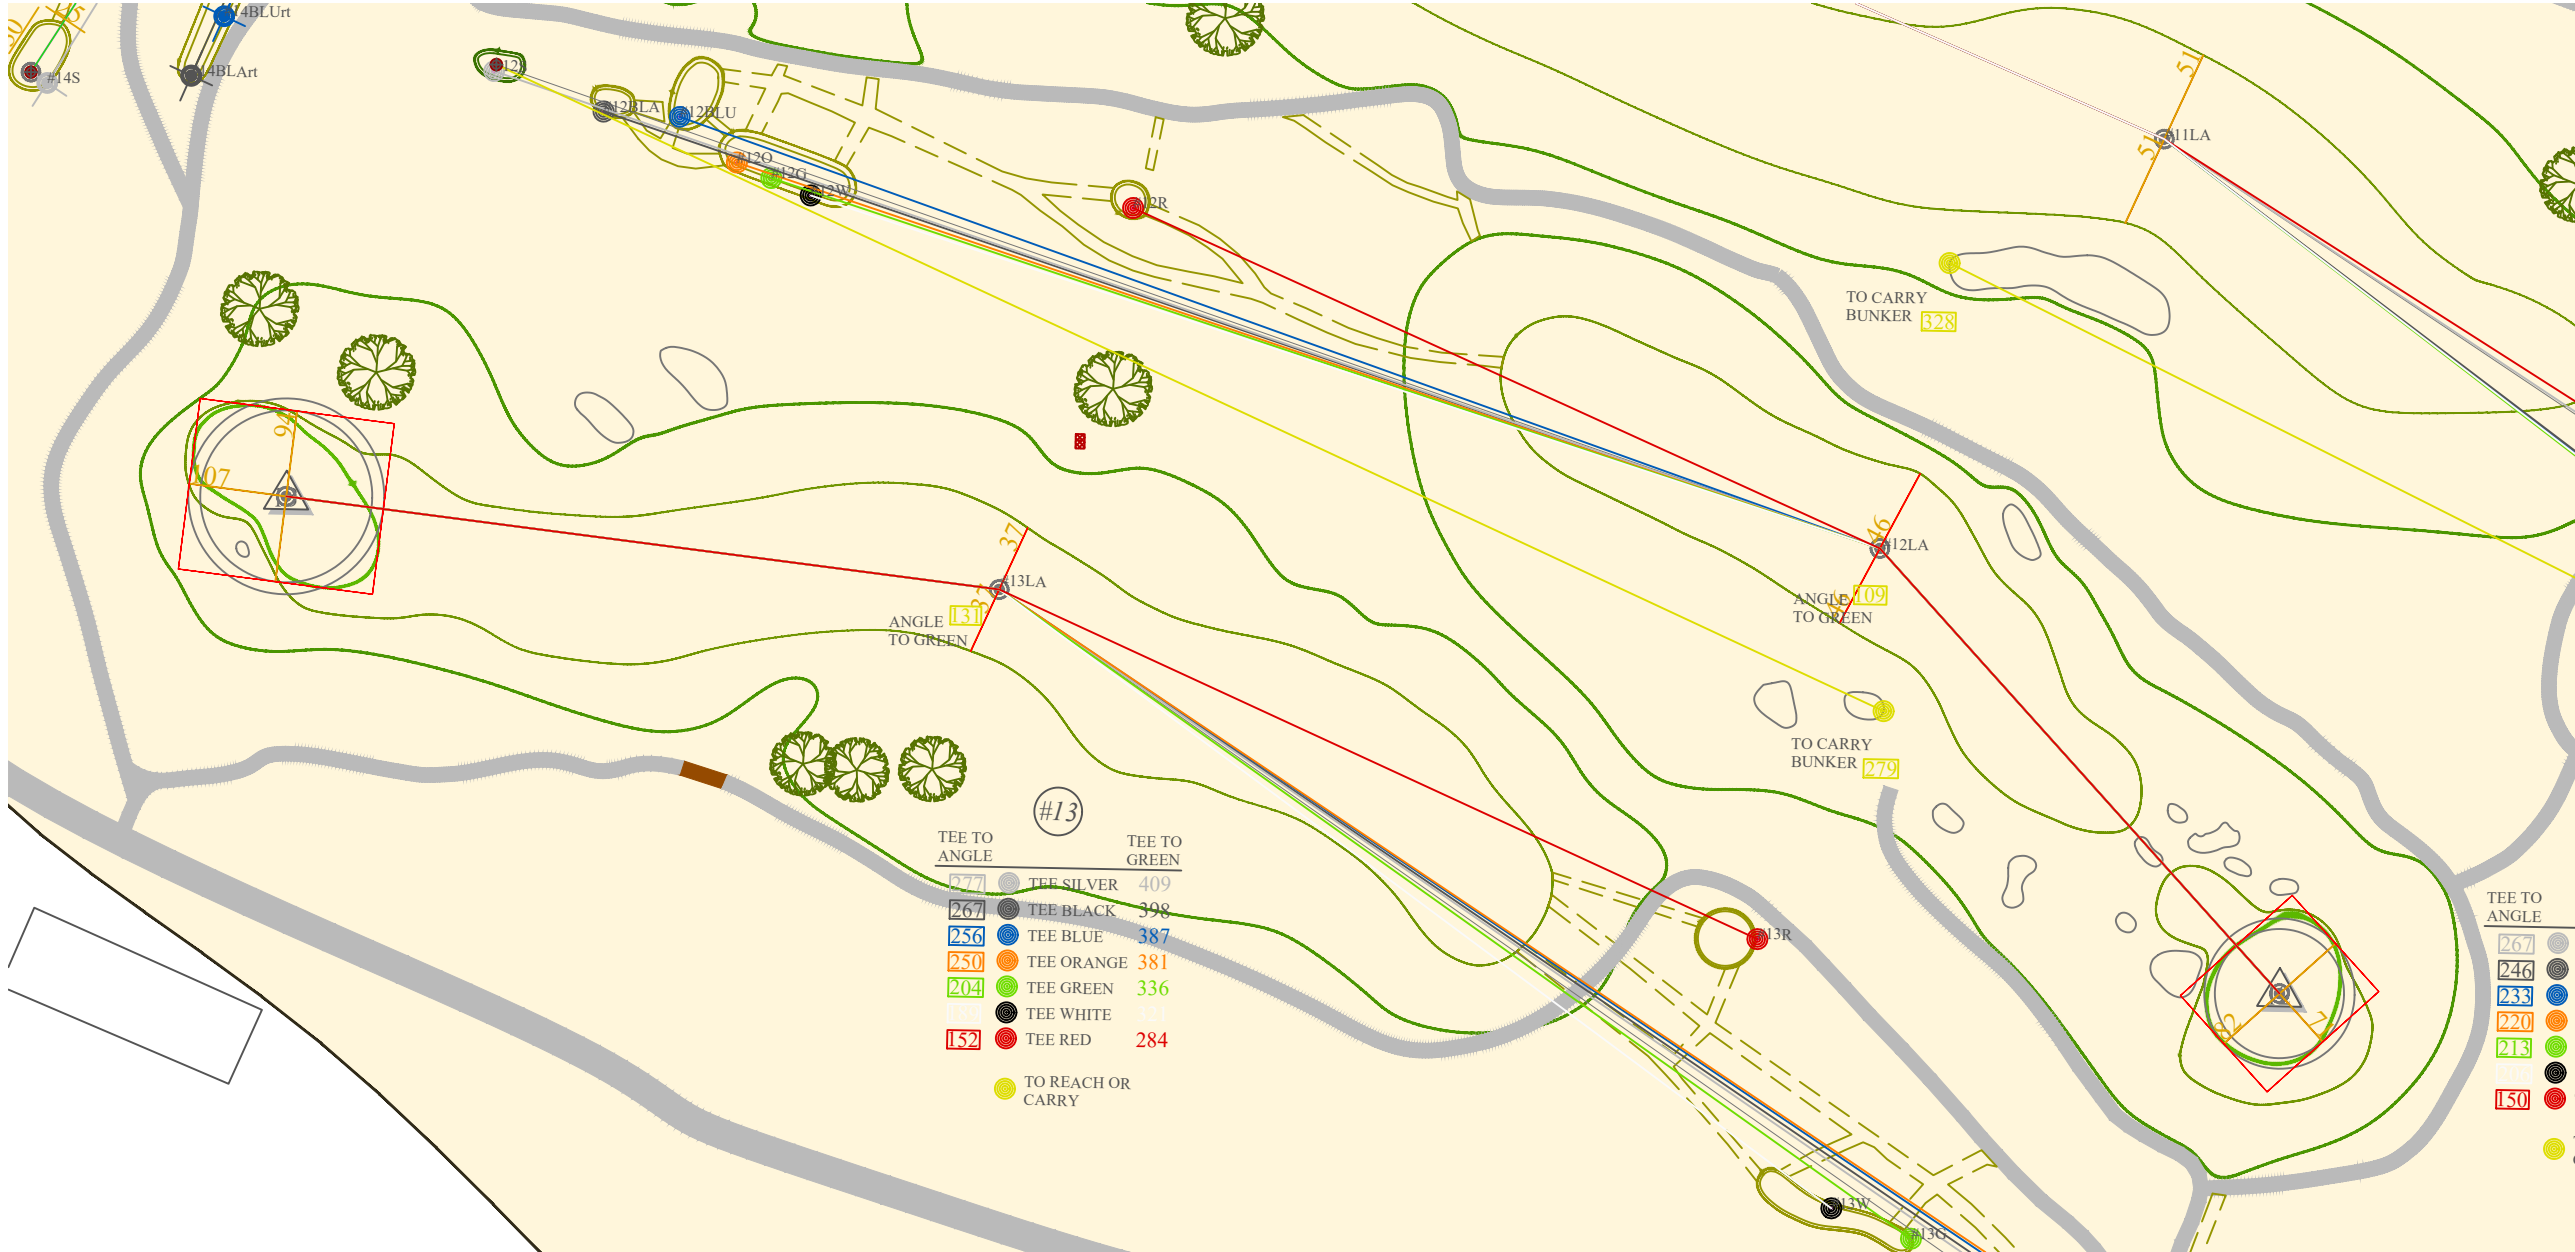


The drawings and related material herein constitute a part of the contract and are intended to be read in conjunction with the specifications and conditions of contract, which are subject to change and may not be reproduced without the written consent of the architect or engineer.

THE HONORS COURSE OOLTEWAH, TENNESSEE

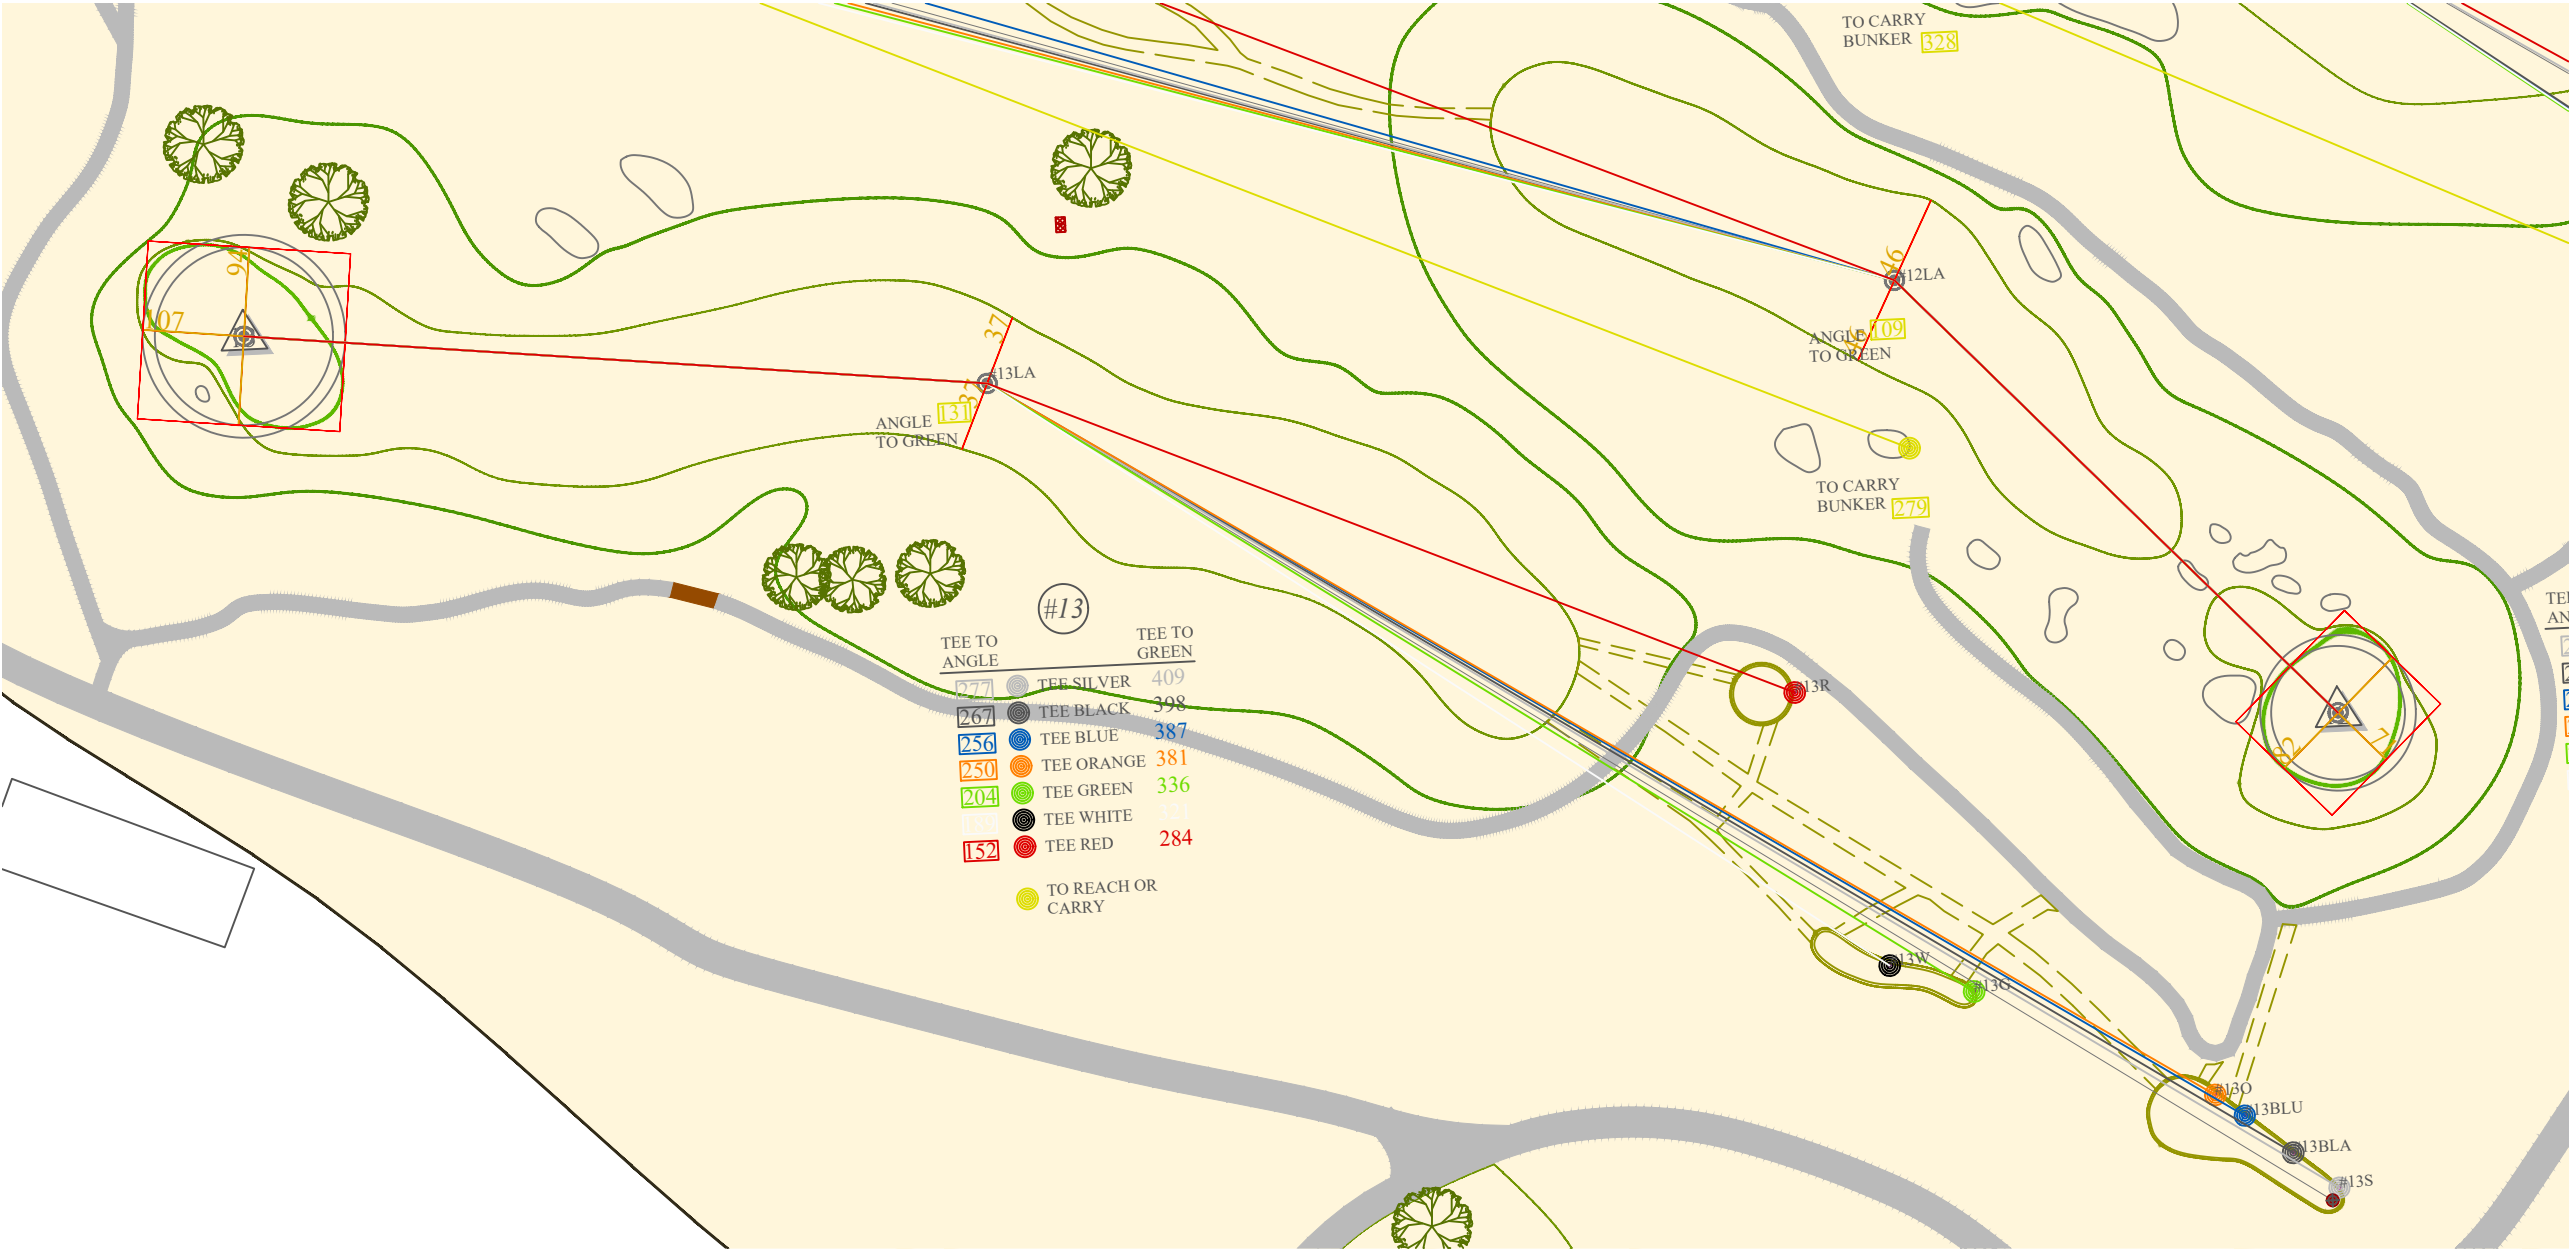

The drawings and written material herein constitute a confidential property and information of ATIS, and are not to be reproduced, distributed, published, or used in any way without the express written consent of the author and its successors.

THE HONORS COURSE OOLTEWAH, TENNESSEE

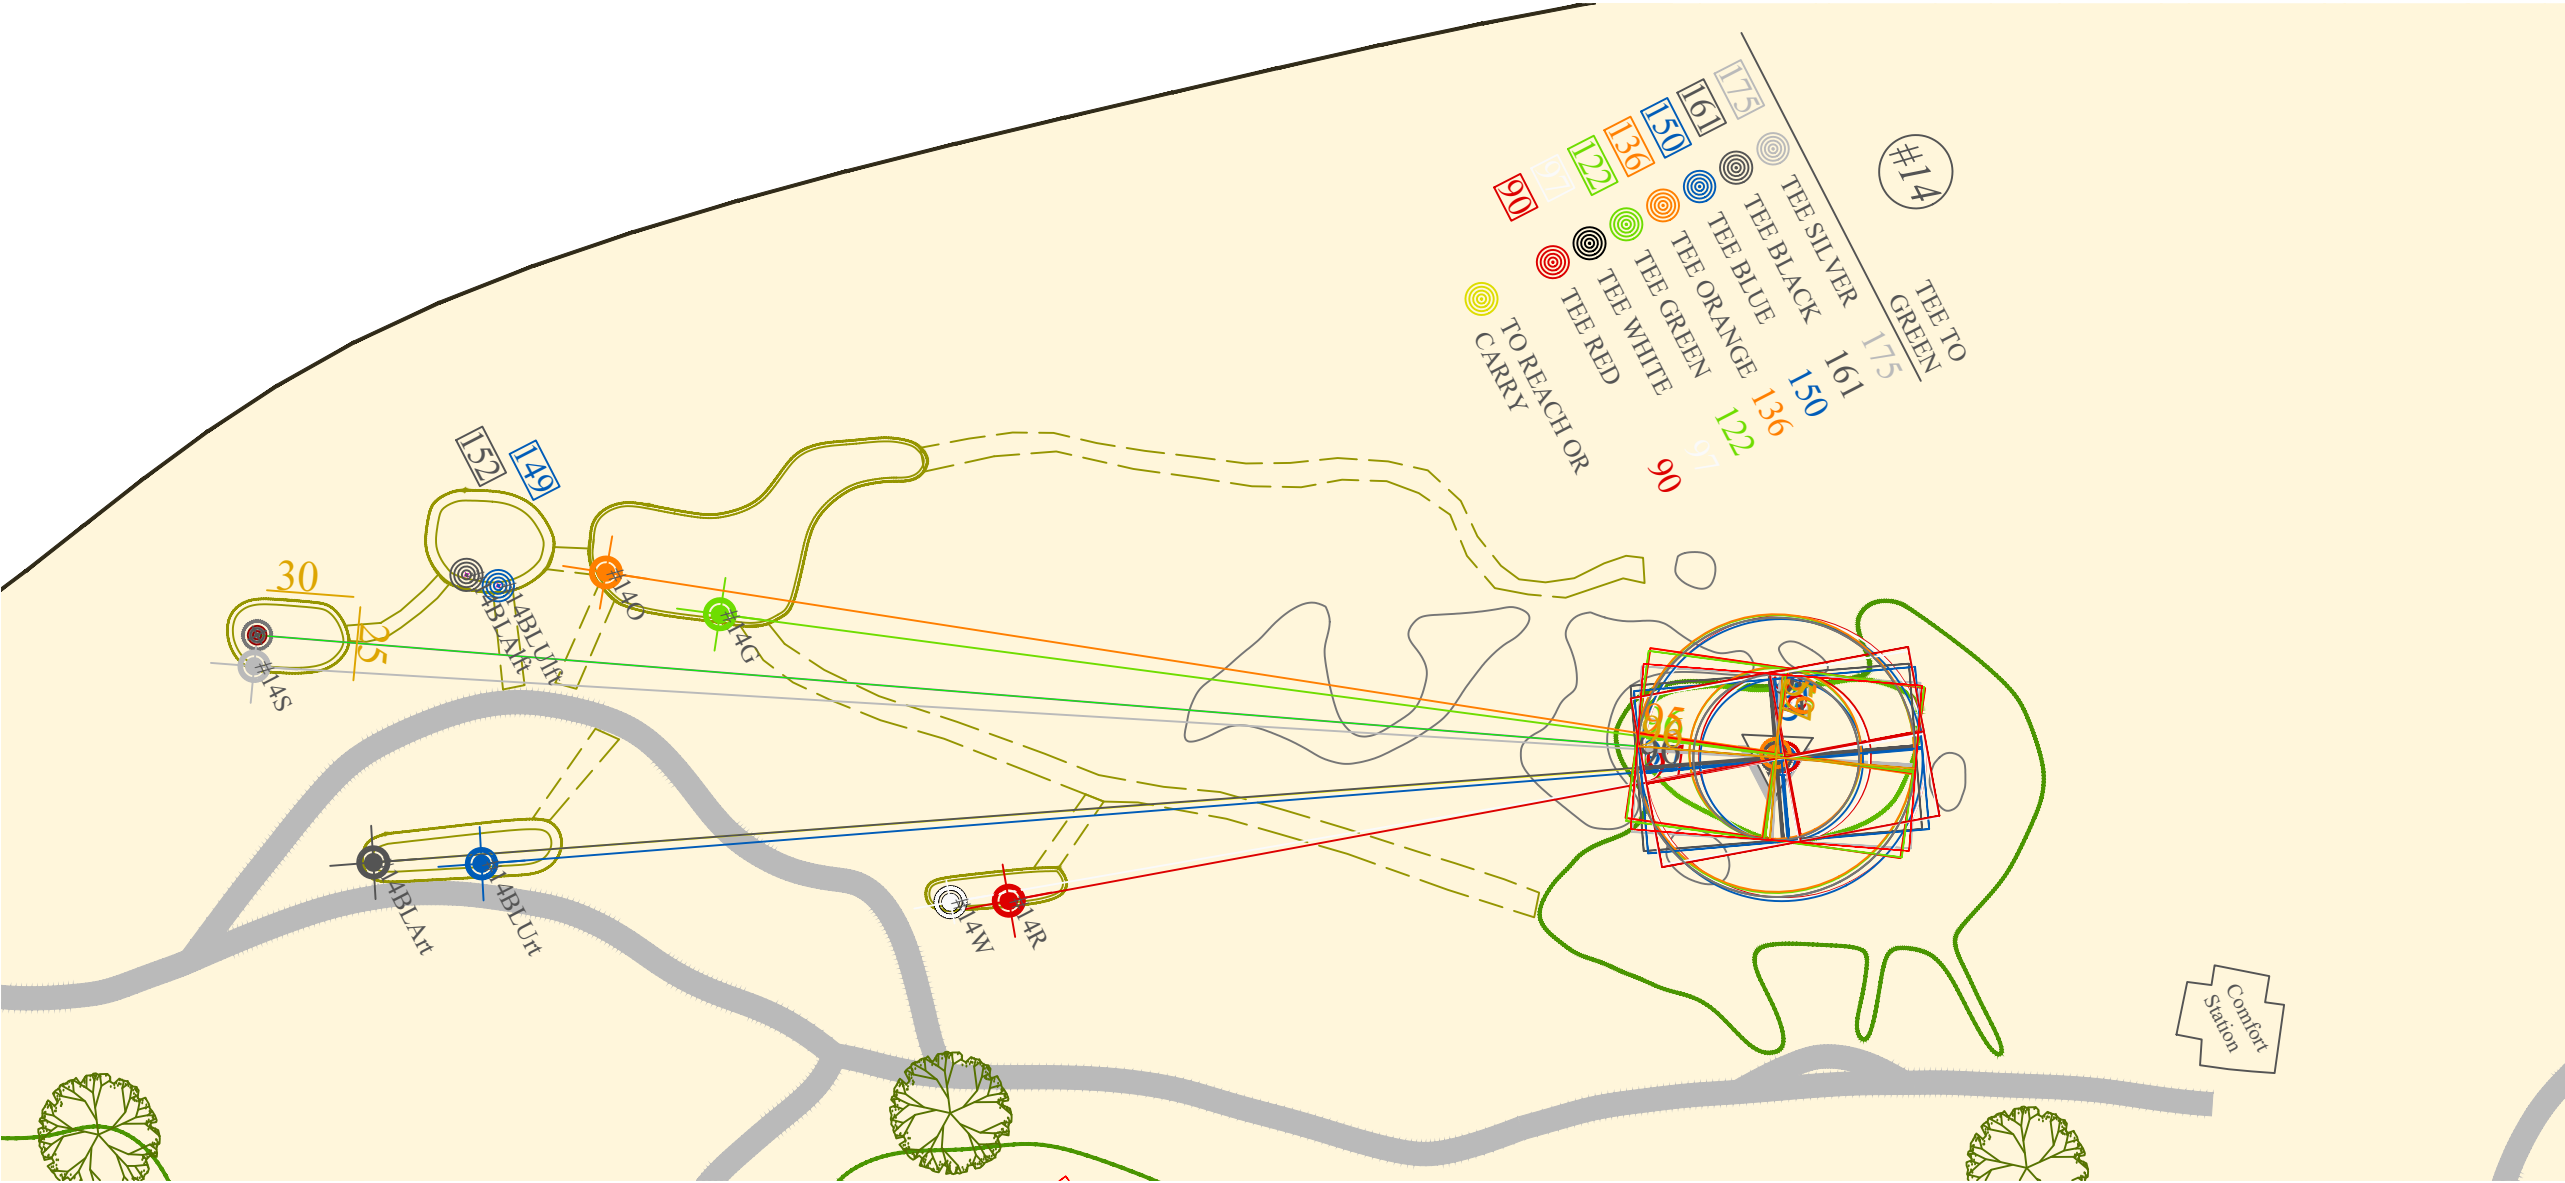

FV #14

January 30, 2023
ATIS Honors Golf for Ashbult Yardage Jan 30 2023.dwg
TAH


GOLF YARDAGE ASBUILT

ATIS GOLF LAND WATER
487 Daddy Green Rd
Christiana, TN 37037
www.GolfLandWater.com
(561) 371-1815




The drawings and written material herein constitute original work of the author and are confidential and not to be reproduced or transmitted in any form or by any means, electronic or mechanical, including photocopying, recording, or by any information storage and retrieval system, without the express written consent of the author and its consultant.

THE HONORS COURSE COLTEWAH, TENNESSEE

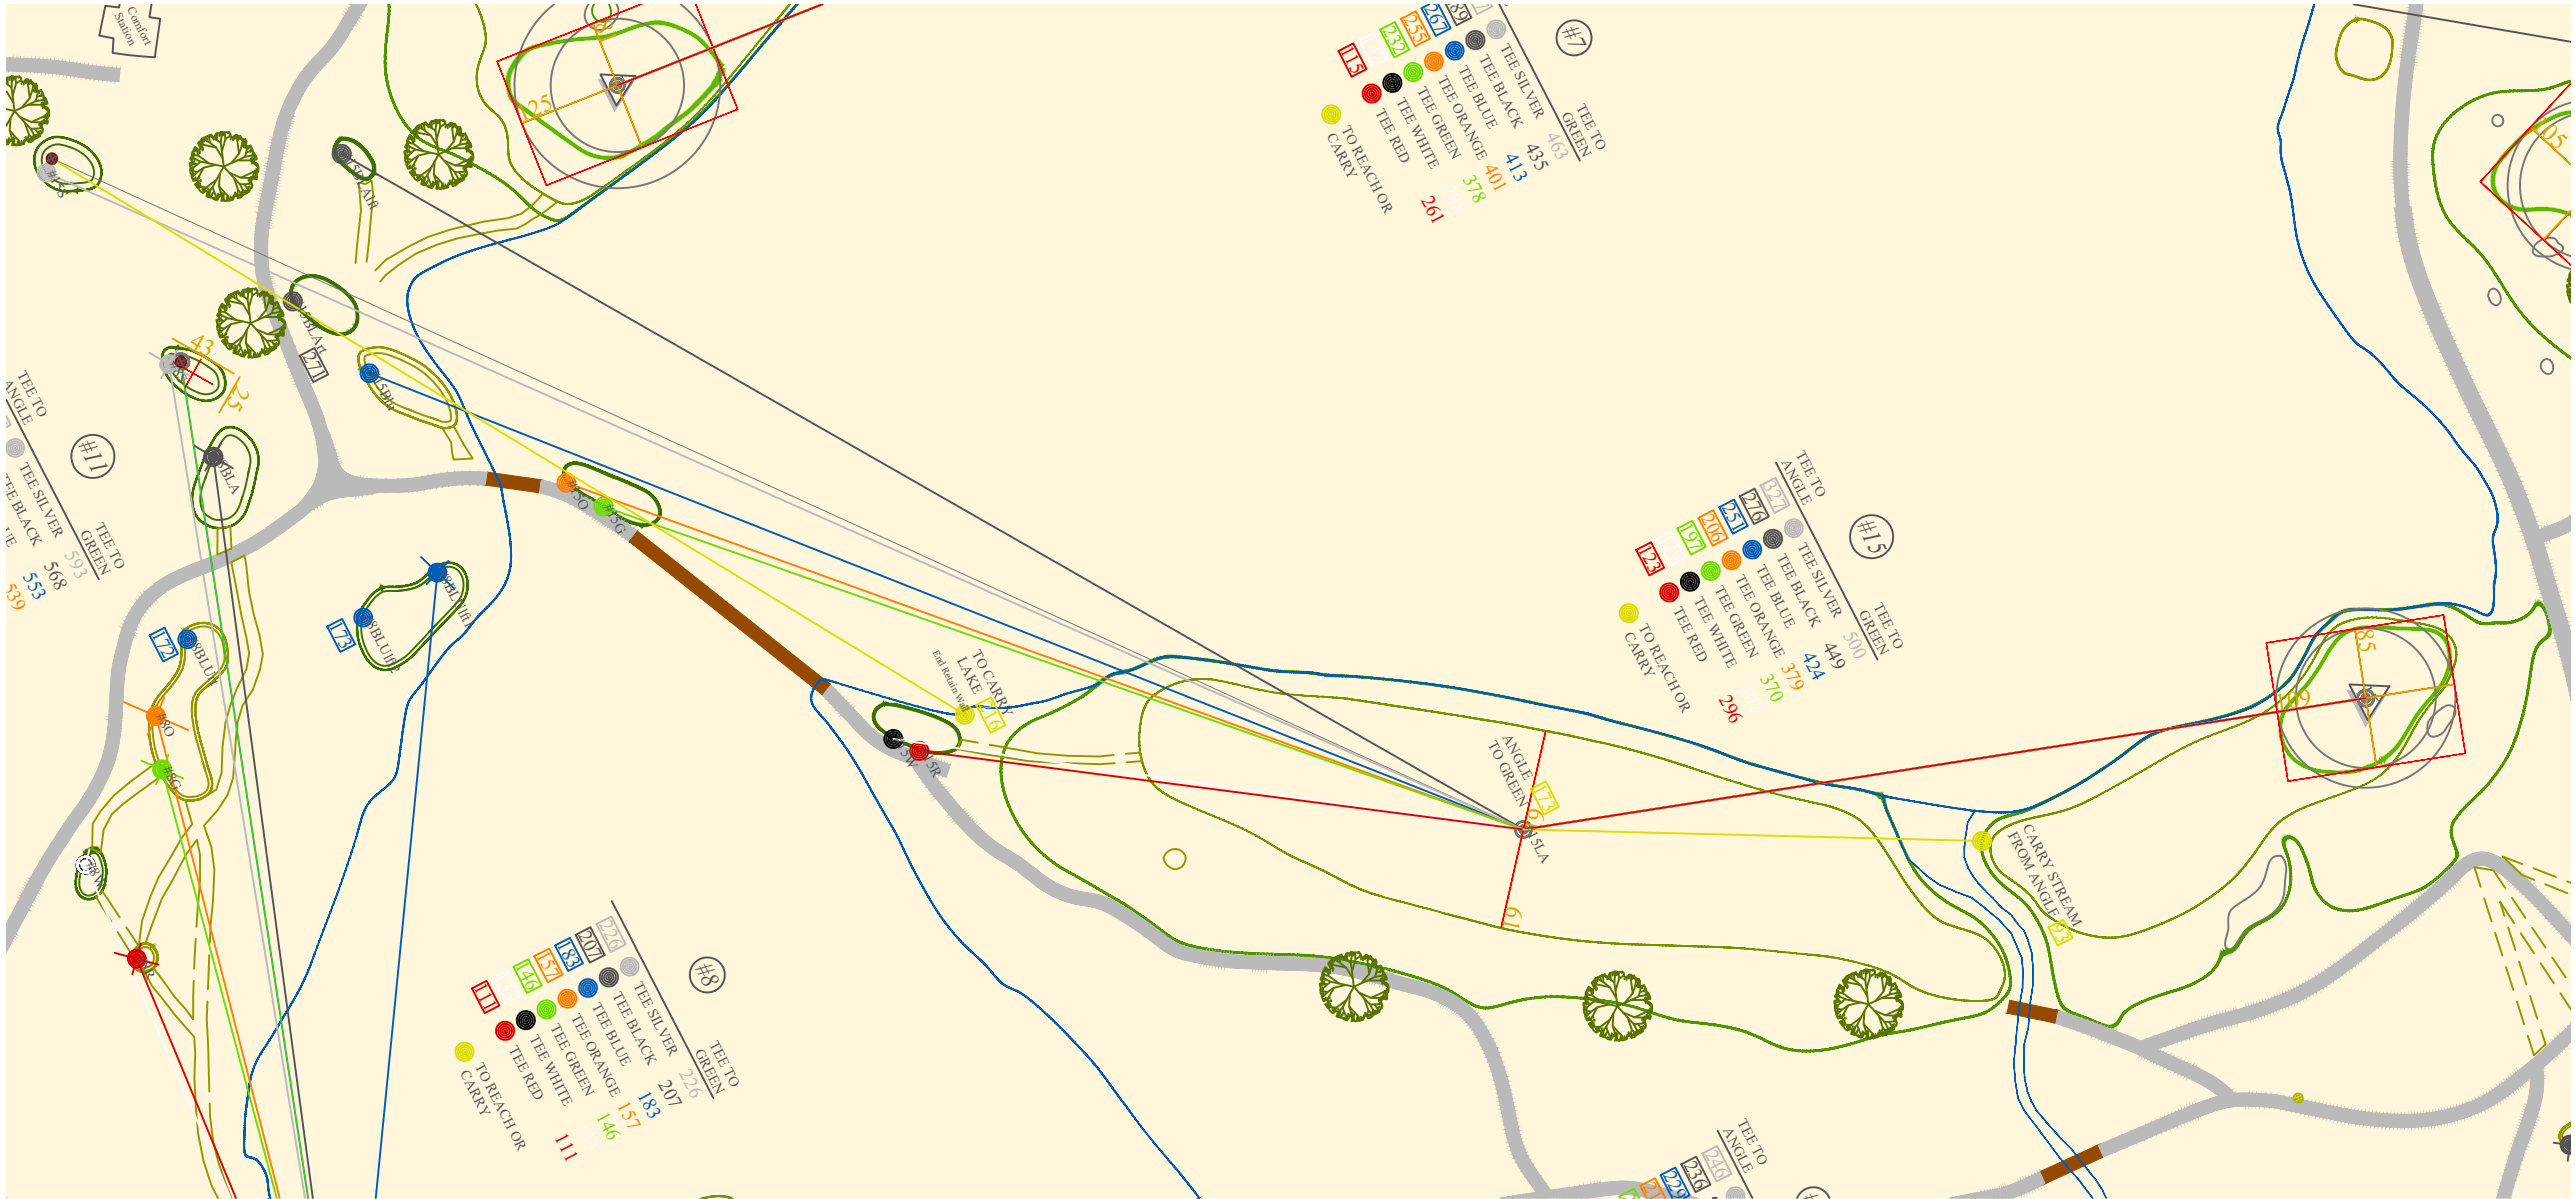

The drawings and written material herein constitute a contract only. If the contract and its conditions, and all referenced drawings and documents are not subject to copyright and may not be reproduced. All drawings are subject to change without notice. The original version remains in the architect's hand at completion.

THE HONORS COURSE OOLTEWAH, TENNESSEE

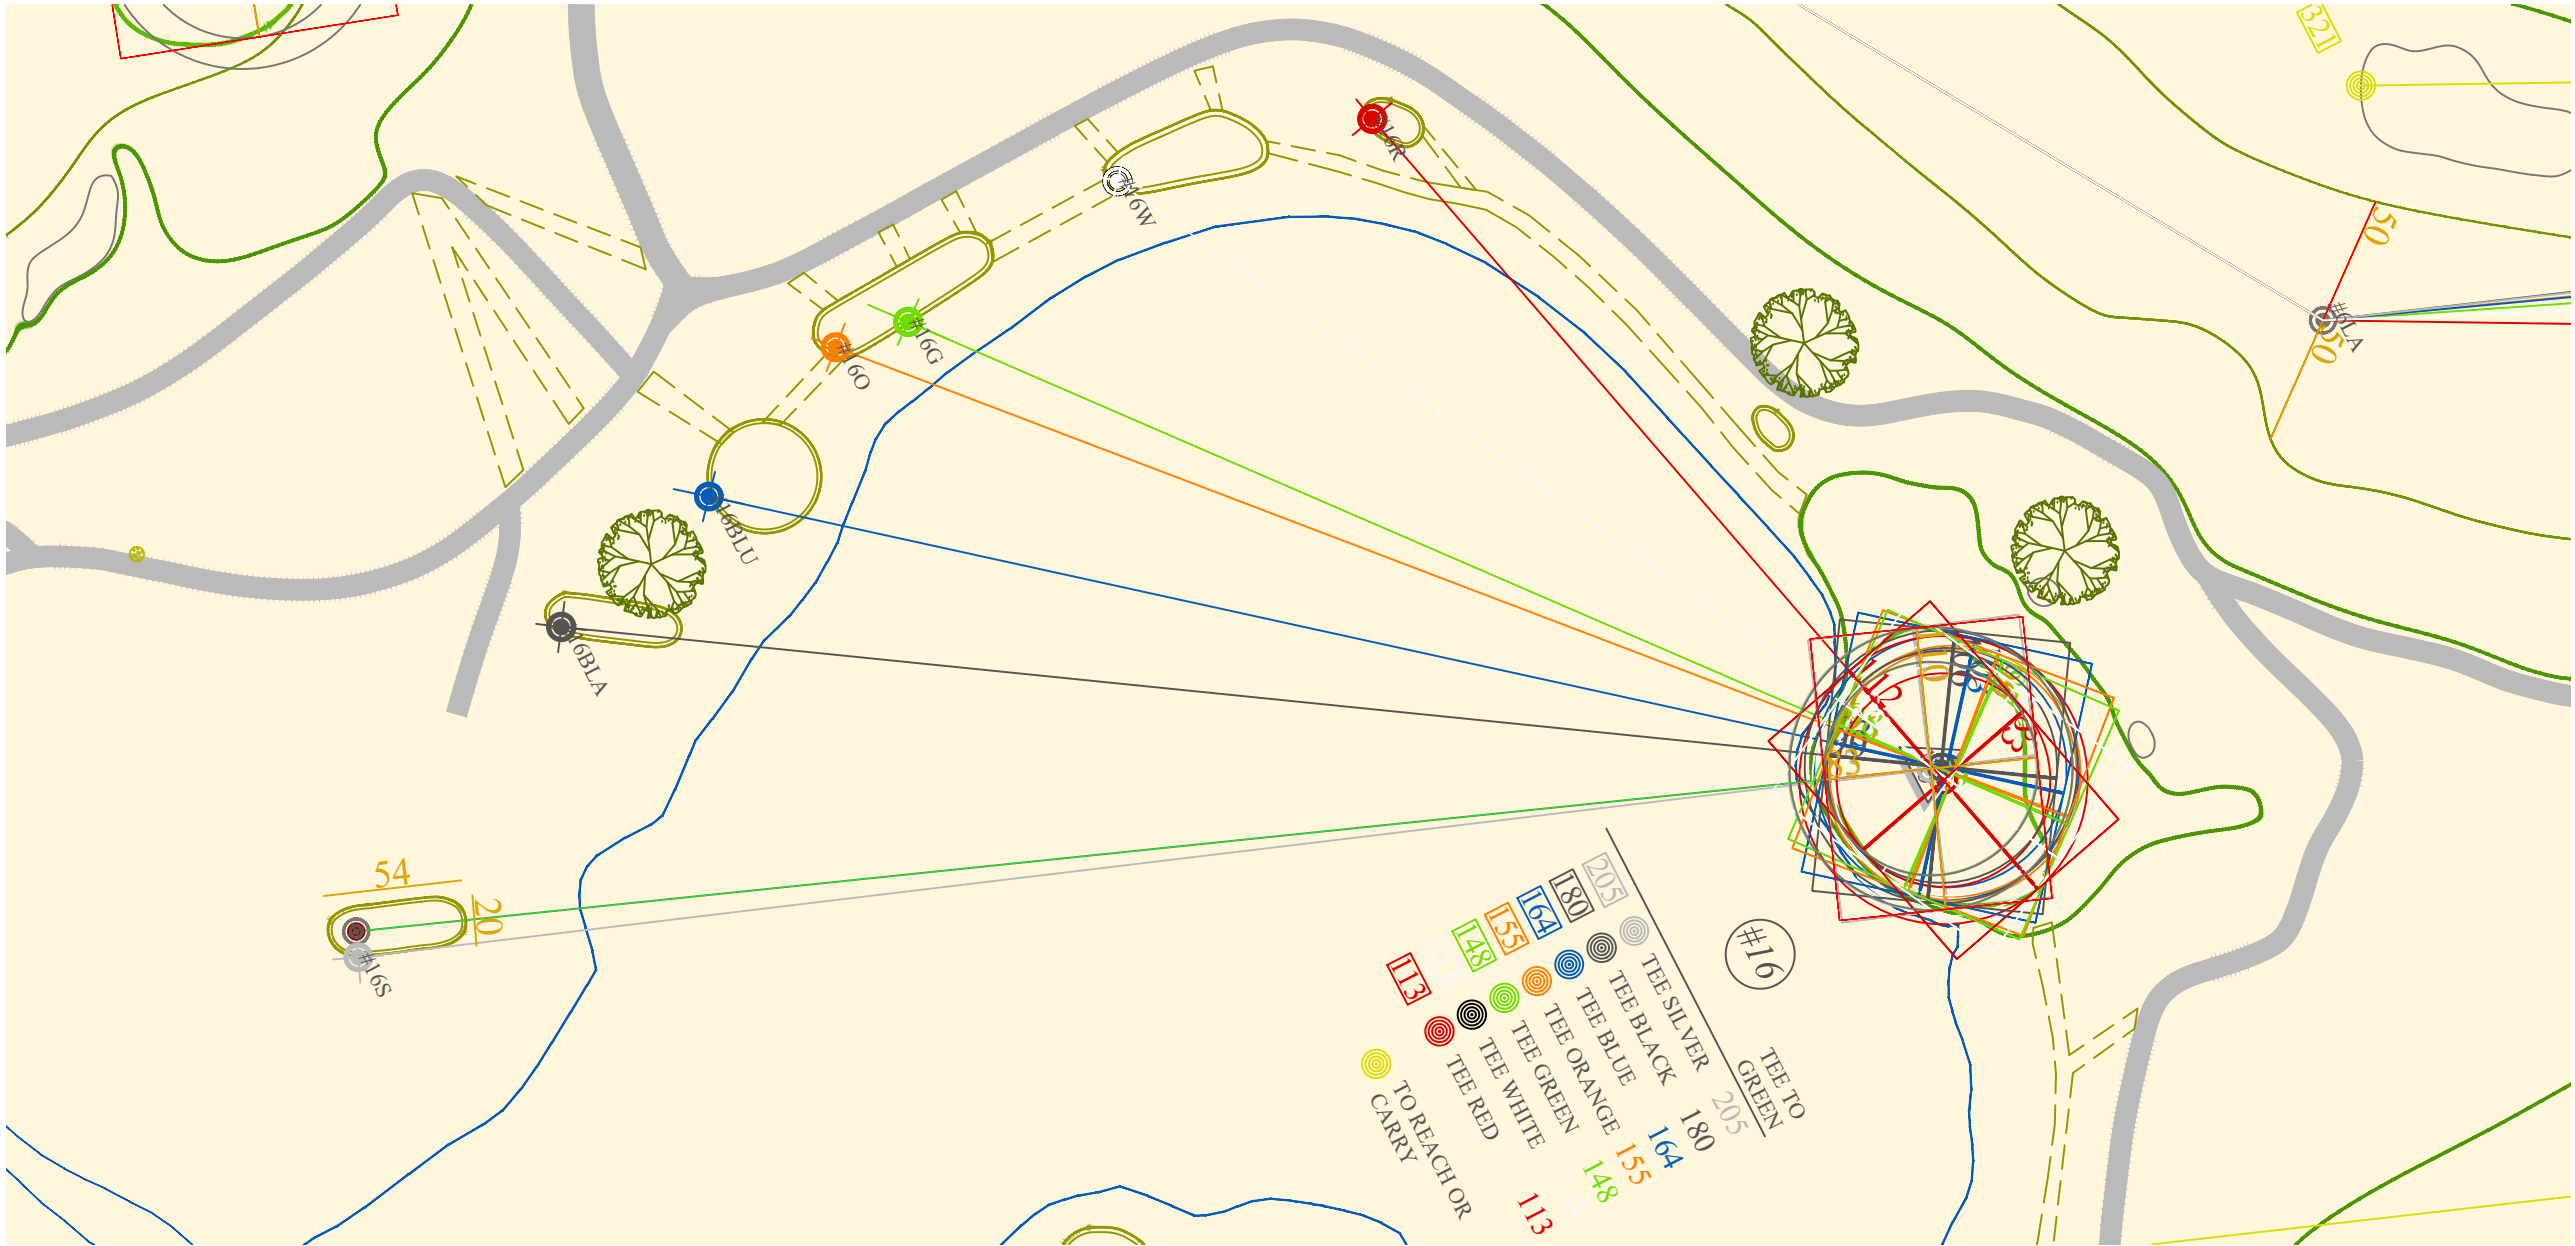

The drawings and written material herein constitute a complete set of the contract and its execution, and no other oral or written agreement or understanding, or other contract, shall be binding on the parties hereto, and no other contract, shall be binding on the parties hereto, and no other contract, shall be binding on the parties hereto.

THE HONORS COURSE OOLTEWAH, TENNESSEE

